

R-9813
62622

Form OR-010-7300-2
4/83

UNITED STATES
DEPARTMENT OF THE INTERIOR
BUREAU OF LAND MANAGEMENT

Section

Township 41 S.

Appl. No. R 65601

6, 12, 7

Range 14 & 14 1/2 E.


Permit No. R 9813

Will. Mer.

RECEIVED

AUG 25 1983

WATER RESOURCES DEPT.
SALEM, OREGON

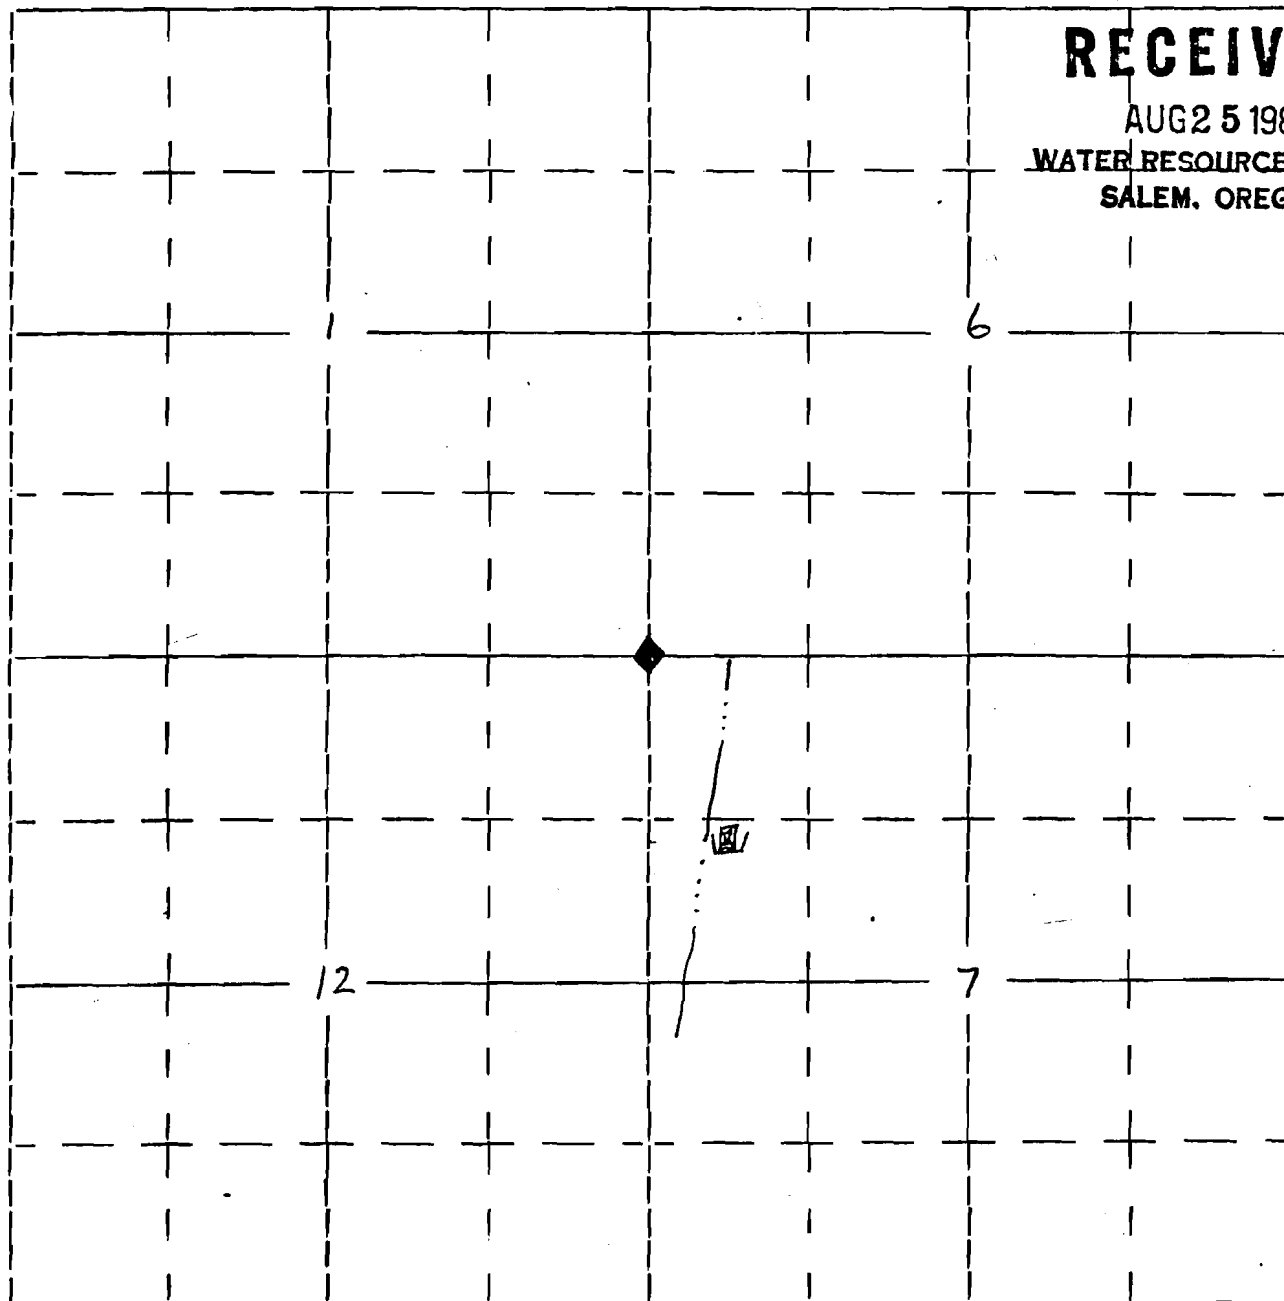

Project is located 1,478' south and 686' east of corner common to section 6, 12 & 7.