

R-9815
62623

Form OR-010-7300-2
4/83

UNITED STATES
DEPARTMENT OF THE INTERIOR
BUREAU OF LAND MANAGEMENT

Section

Township 37 S.

Appl. No. R-68603

Range 11 $\frac{1}{2}$ E.


Permit No. R 9815

Will. Mer.

RECEIVED

AUG 25 1983

WATER RESOURCES DEPT.
SALEM, OREGON

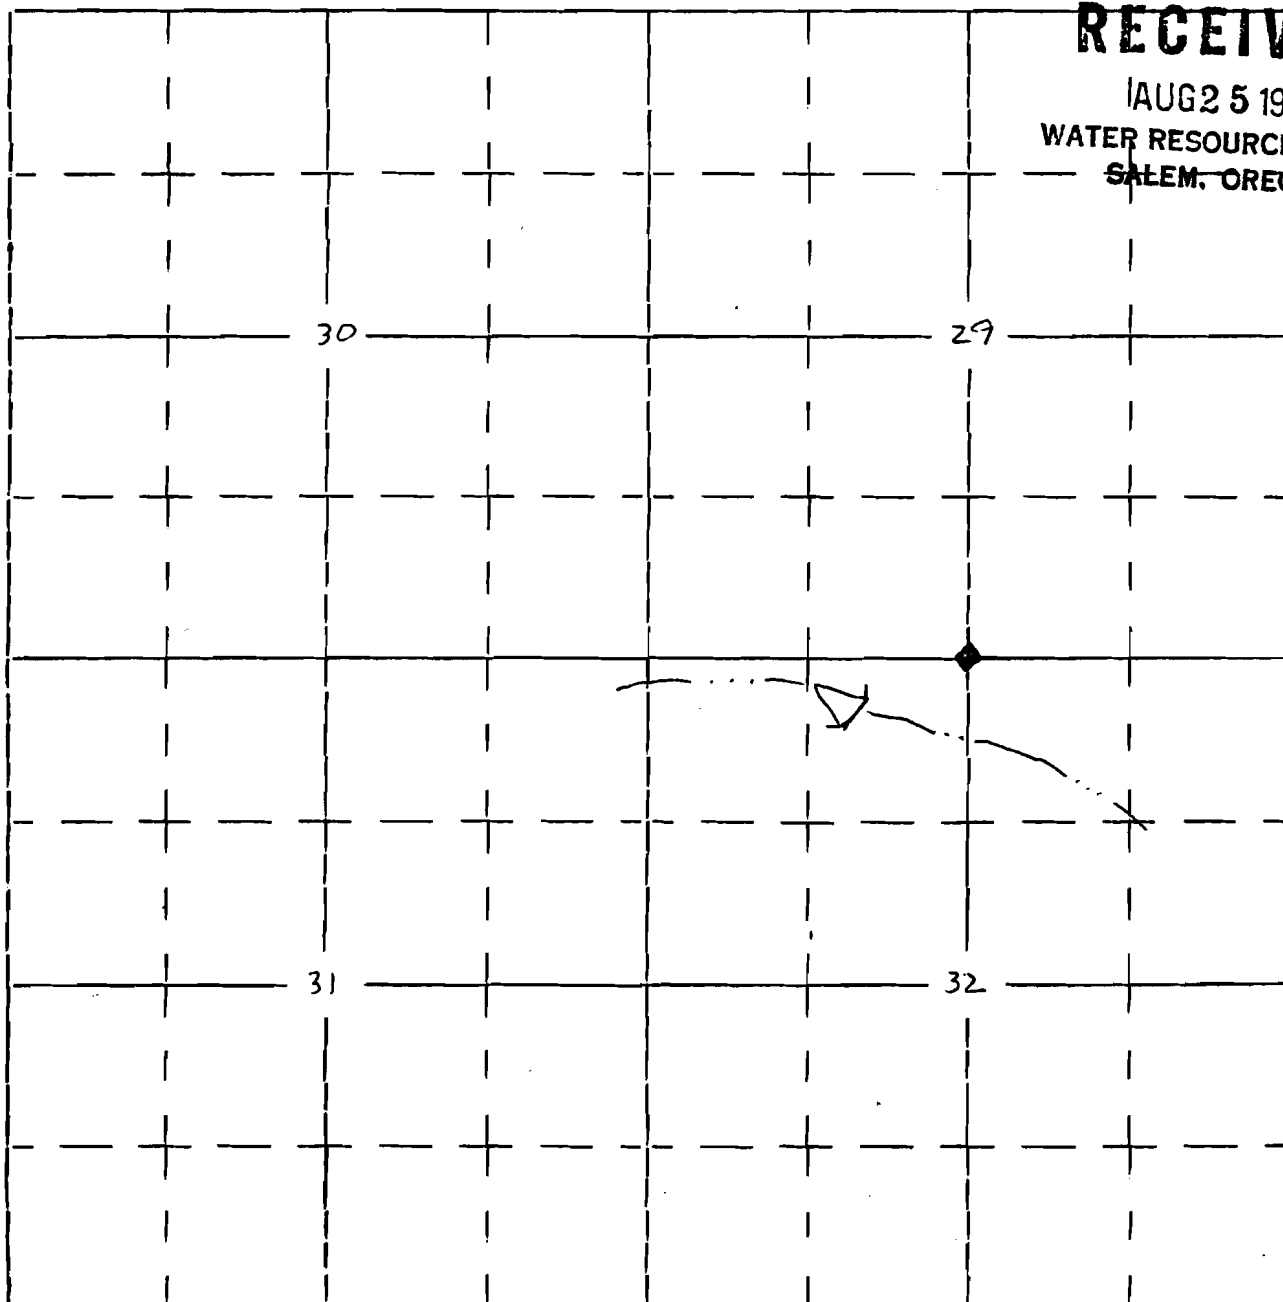

Project is located 438' south and 1,250' west of $\frac{1}{4}$ corner
common to sections 29 & 32.