

R-9817
62625

Form OR-010-7300-2
4/83

UNITED STATES
DEPARTMENT OF THE INTERIOR
BUREAU OF LAND MANAGEMENT

Section

Township 39 S

Appl. No. R 65205

21, 22, 27 & 28

Range 14 E


Permit No. R 9817

Will. Mer.

RECEIVED

AUG 25 1983

WATER RESOURCES DEPT.
SALEM, OREGON

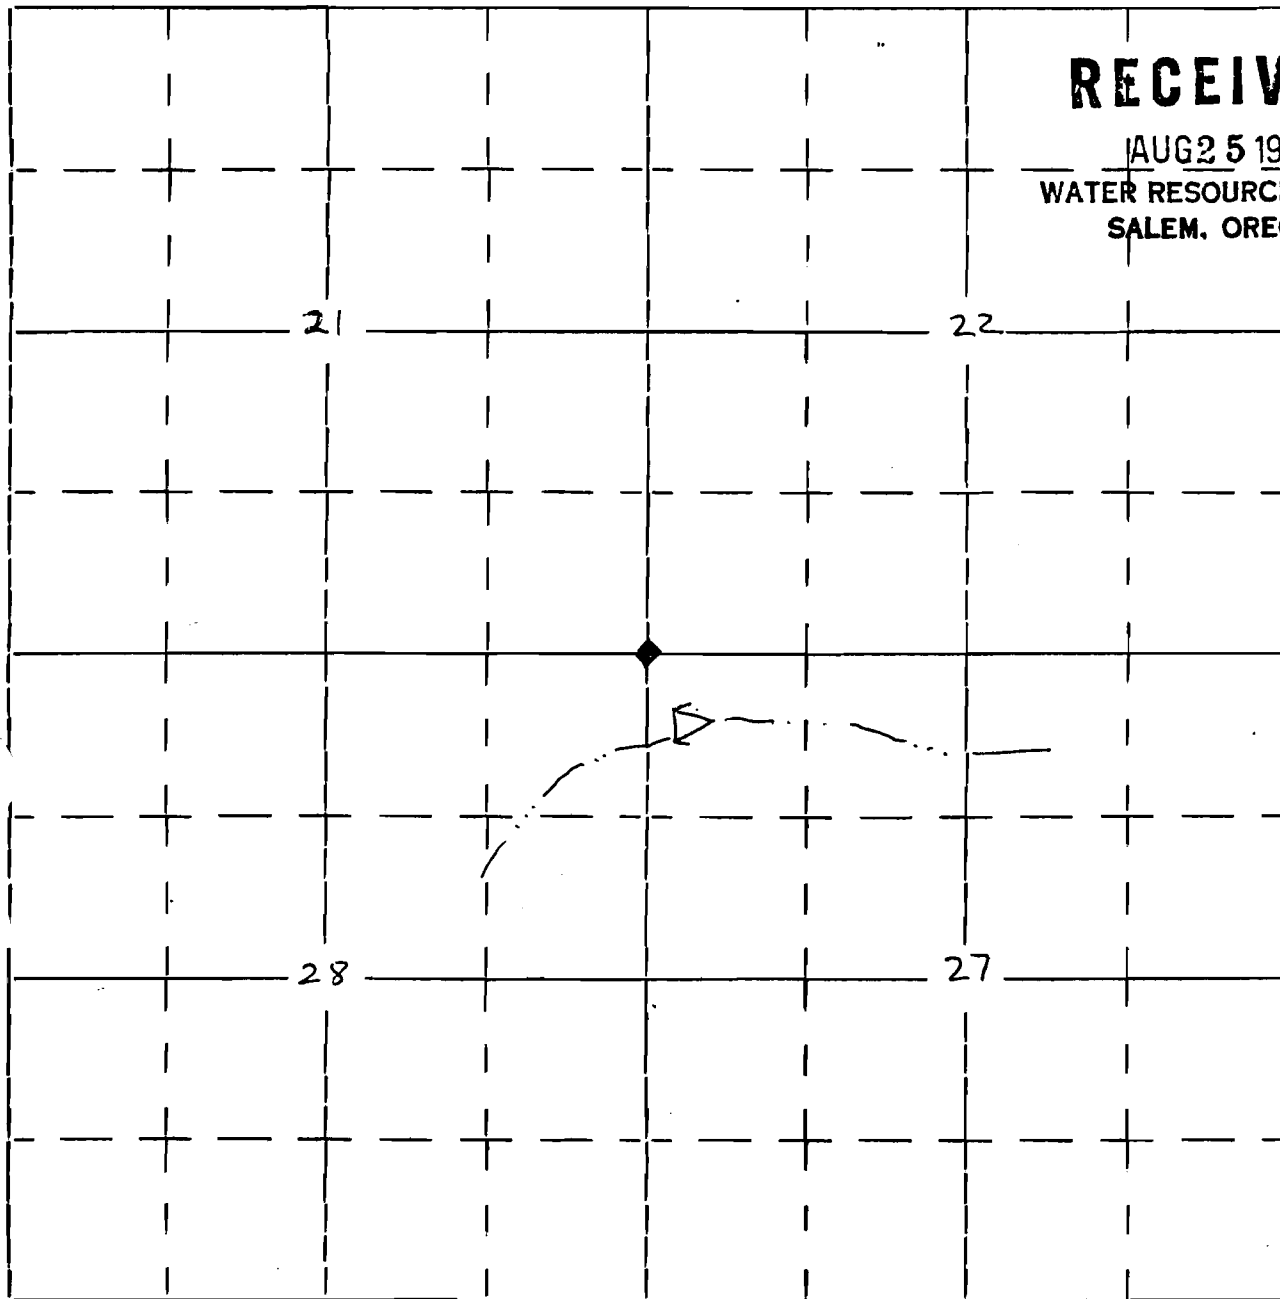

Project is located 660' south and 495' east of corner common
to sections 21, 22, 27 & 28.