

R-9818

6262p

Form OR-010-7300-2

4/83

UNITED STATES
DEPARTMENT OF THE INTERIOR
BUREAU OF LAND MANAGEMENT

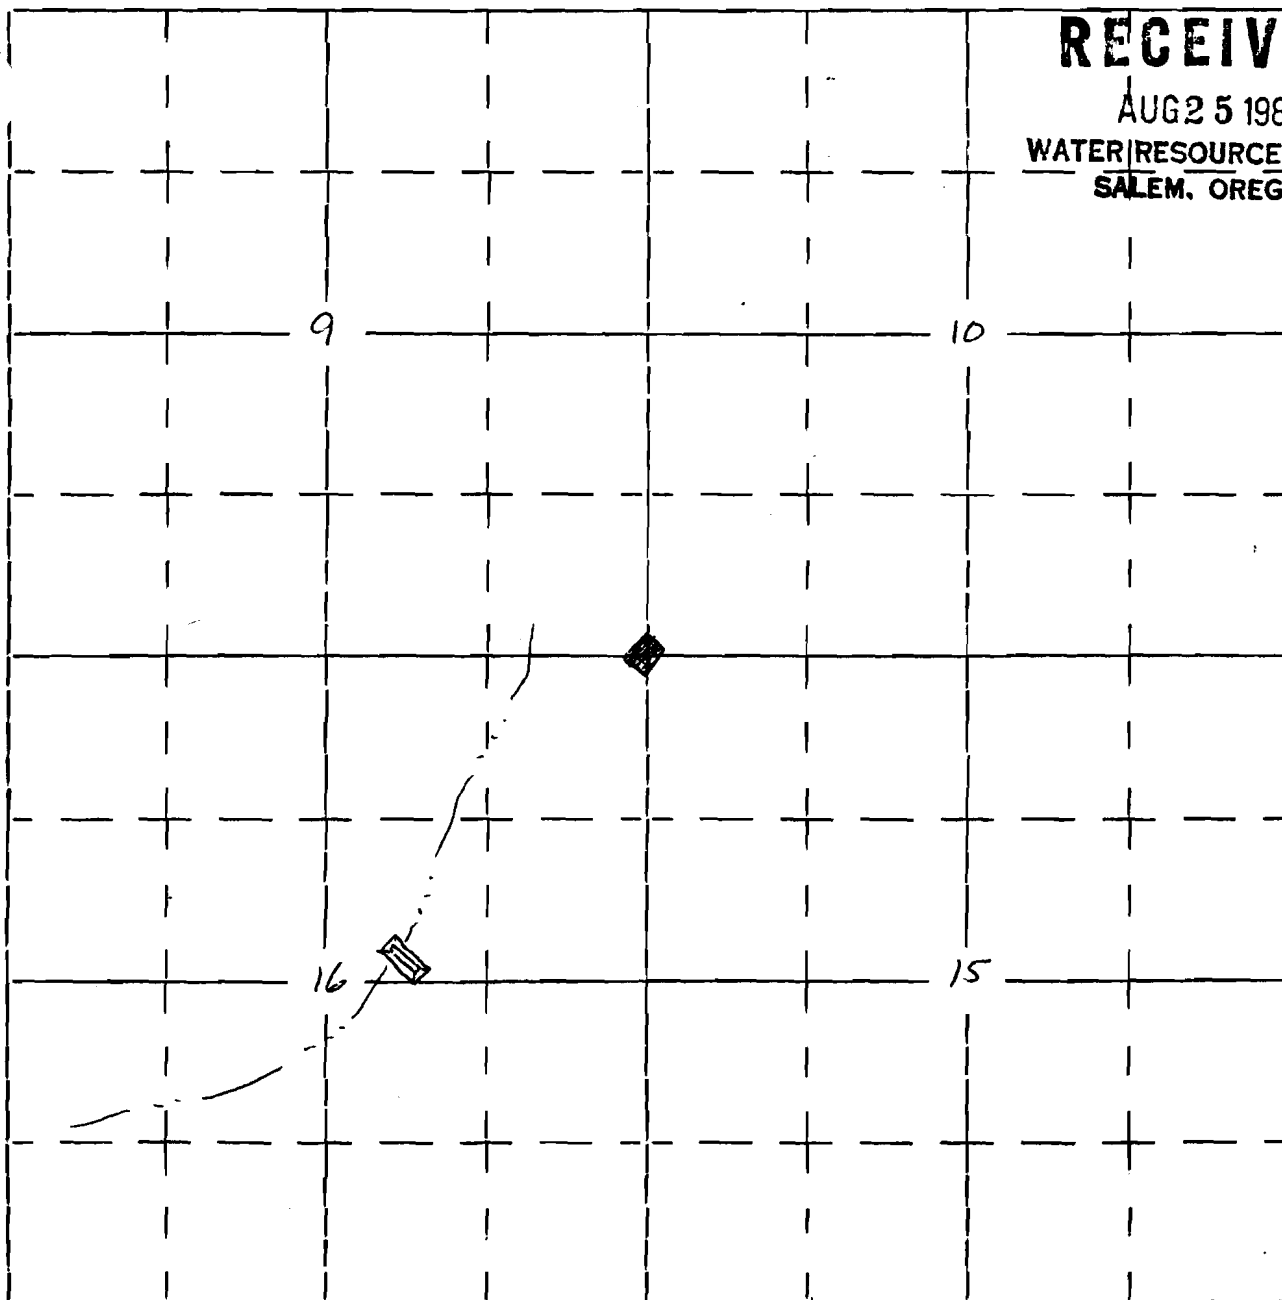
Section

Township 40 S.Appl. No. R-656069, 10, 15 & 16Range 14 $\frac{1}{2}$ E.Permit No. R 9818

Will. Mer.

RECEIVED

AUG 25 1983

WATER RESOURCES DEPT.
SALEM, OREGON

Project is located 2,593' south and 2,093' west of corner
common to sections 9, 10, 15 & 16.