

R-9819
62627

Form OR-010-7300-2
4/83

UNITED STATES
DEPARTMENT OF THE INTERIOR
BUREAU OF LAND MANAGEMENT

Section

Township 41 S.


Appl. No. R-65607

8, 9, 16 & 17

Range 14 E.

Permit No. R 9819

Will. Mer.

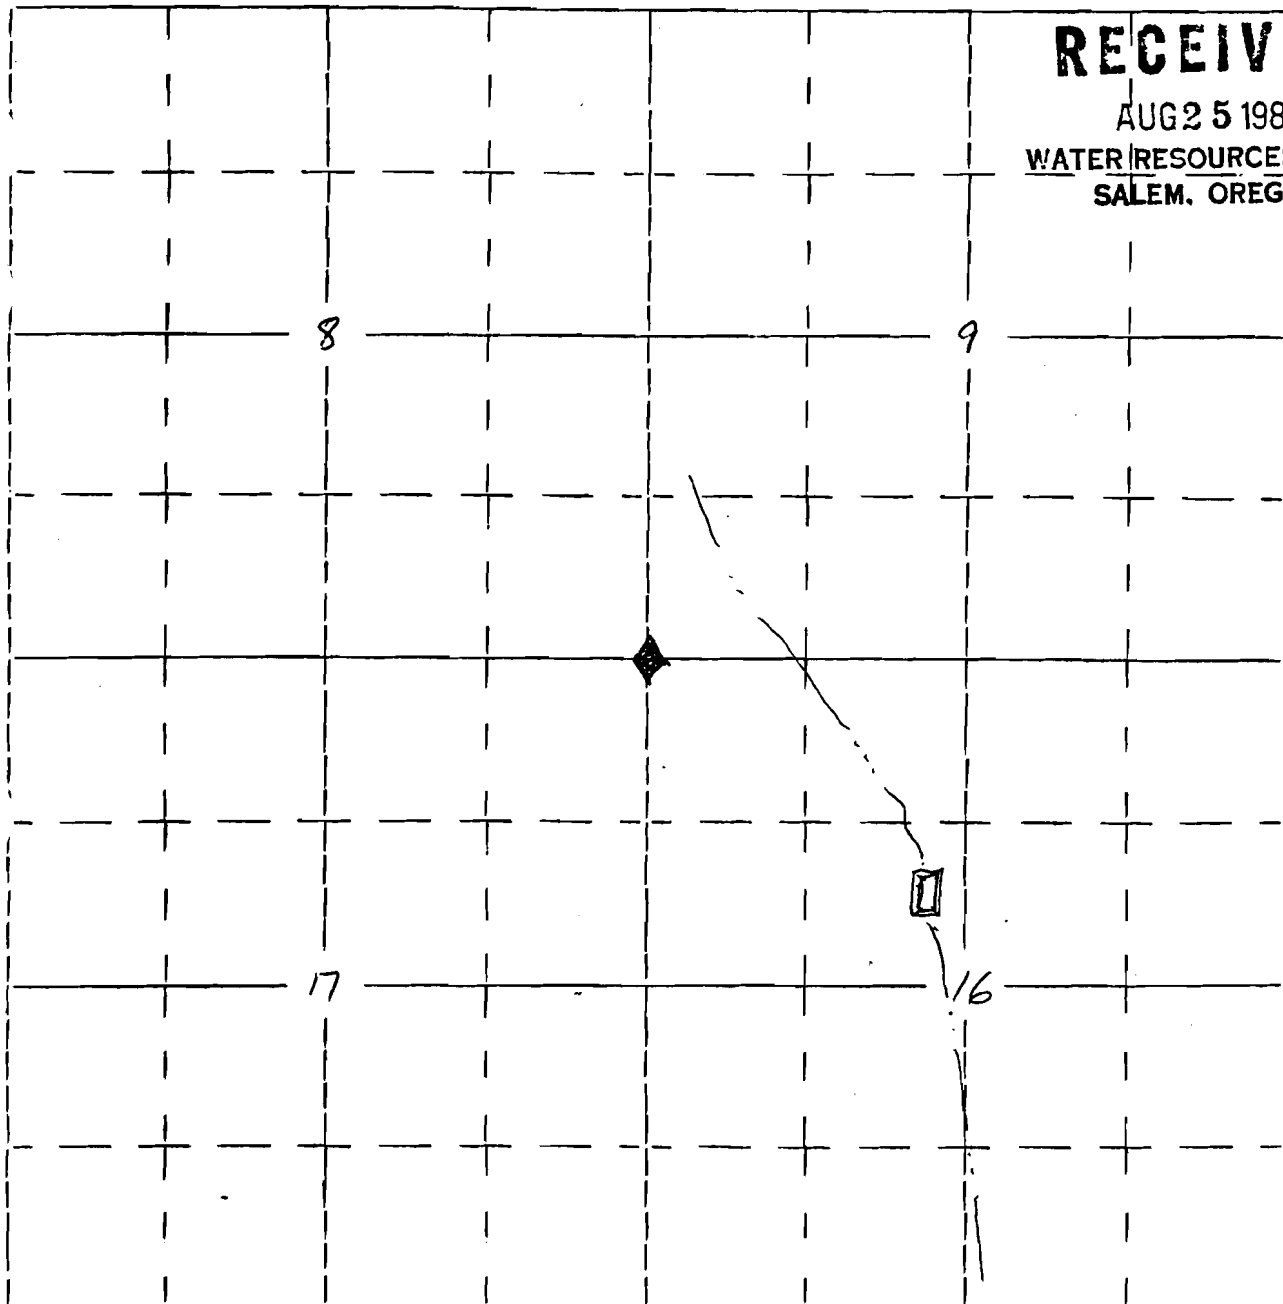

RECEIVED

AUG 25 1983

WATER RESOURCES DEPT.
SALEM, OREGON

Waterhole is located 1,815' south and 2,310' east of corner
Common to sections 8, 9, 16 & 17.