

R-9821

Form OR-010-7300-2
4/83

UNITED STATES
DEPARTMENT OF THE INTERIOR
BUREAU OF LAND MANAGEMENT

Section

Township 41 S.

Appl. No. R-65609

16, 17, 20 & 21

Range 14 E.


Permit No. R 9821

Will. Mer.

RECEIVED

AUG 25 1983

WATER RESOURCES DEPT.
SALEM, OREGON

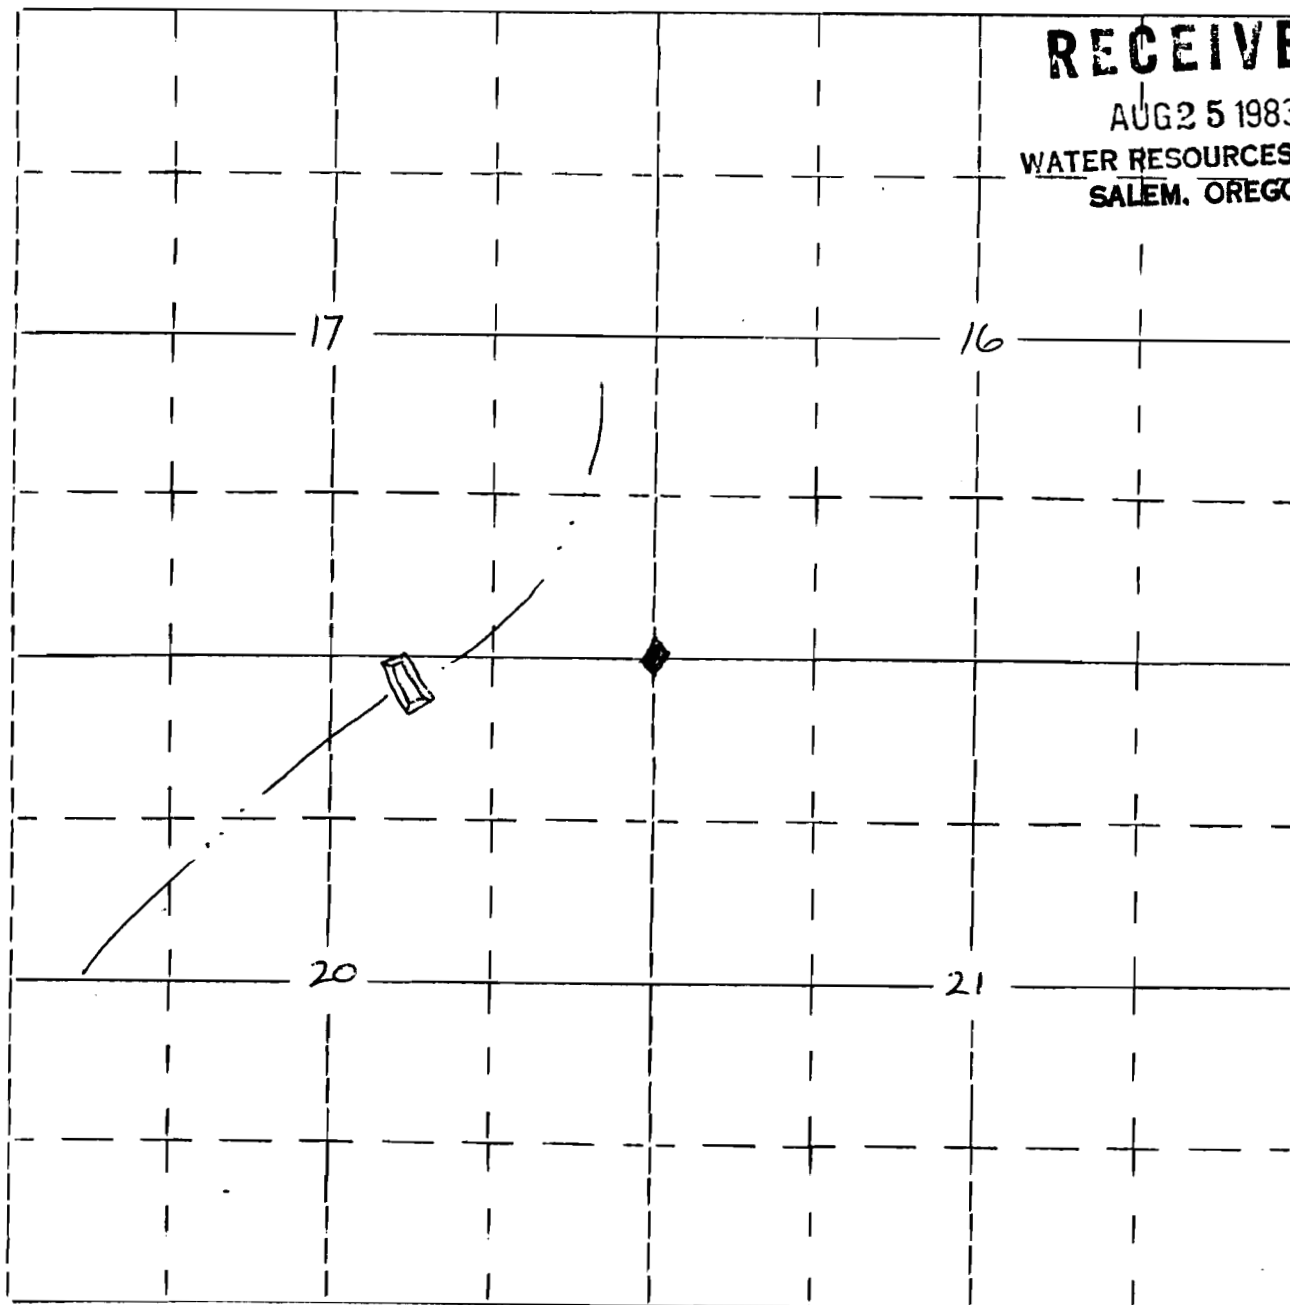

Waterhole is located 1703' west and 68' south of corner
Common to sections 16, 17, 20 & 21.