

R-9822
62629

Form OR-010-7300-2
4/83

UNITED STATES
DEPARTMENT OF THE INTERIOR
BUREAU OF LAND MANAGEMENT

Section

Township 41 S.

Appl. No. R-65610

16, 17, 20 & 21


Range 14 E.

Permit No. R 9822

Will. Mer.

RECEIVED

AUG 25 1983
WATER RESOURCES DEPT.
SALEM, OREGON

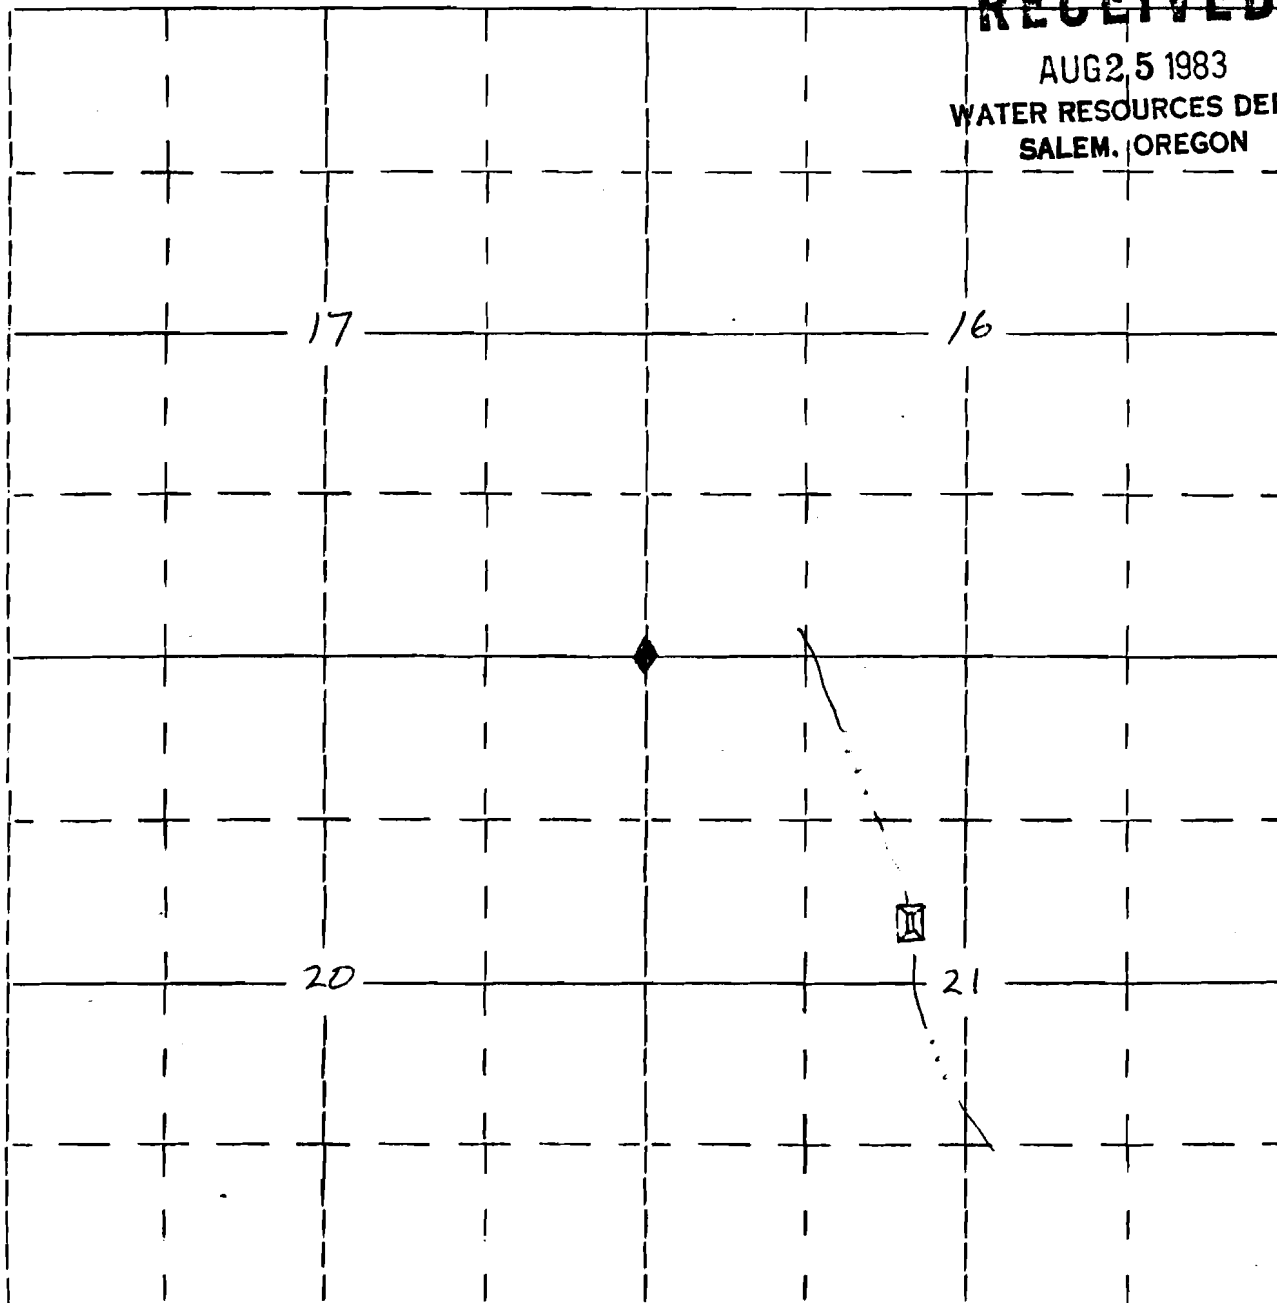

Project is located 2,145' south and 2,475 E. of corner common to sections 16, 17, 20 & 21.