

R 9823
62630

Form OR-010-7300-2
4/83

UNITED STATES
DEPARTMENT OF THE INTERIOR
BUREAU OF LAND MANAGEMENT

Section

6

Township 39 S.


Appl. No. R-66086

Range 23 E.

Permit No. R 9823

Will. Mer.

PARSNIP RES. (5529)

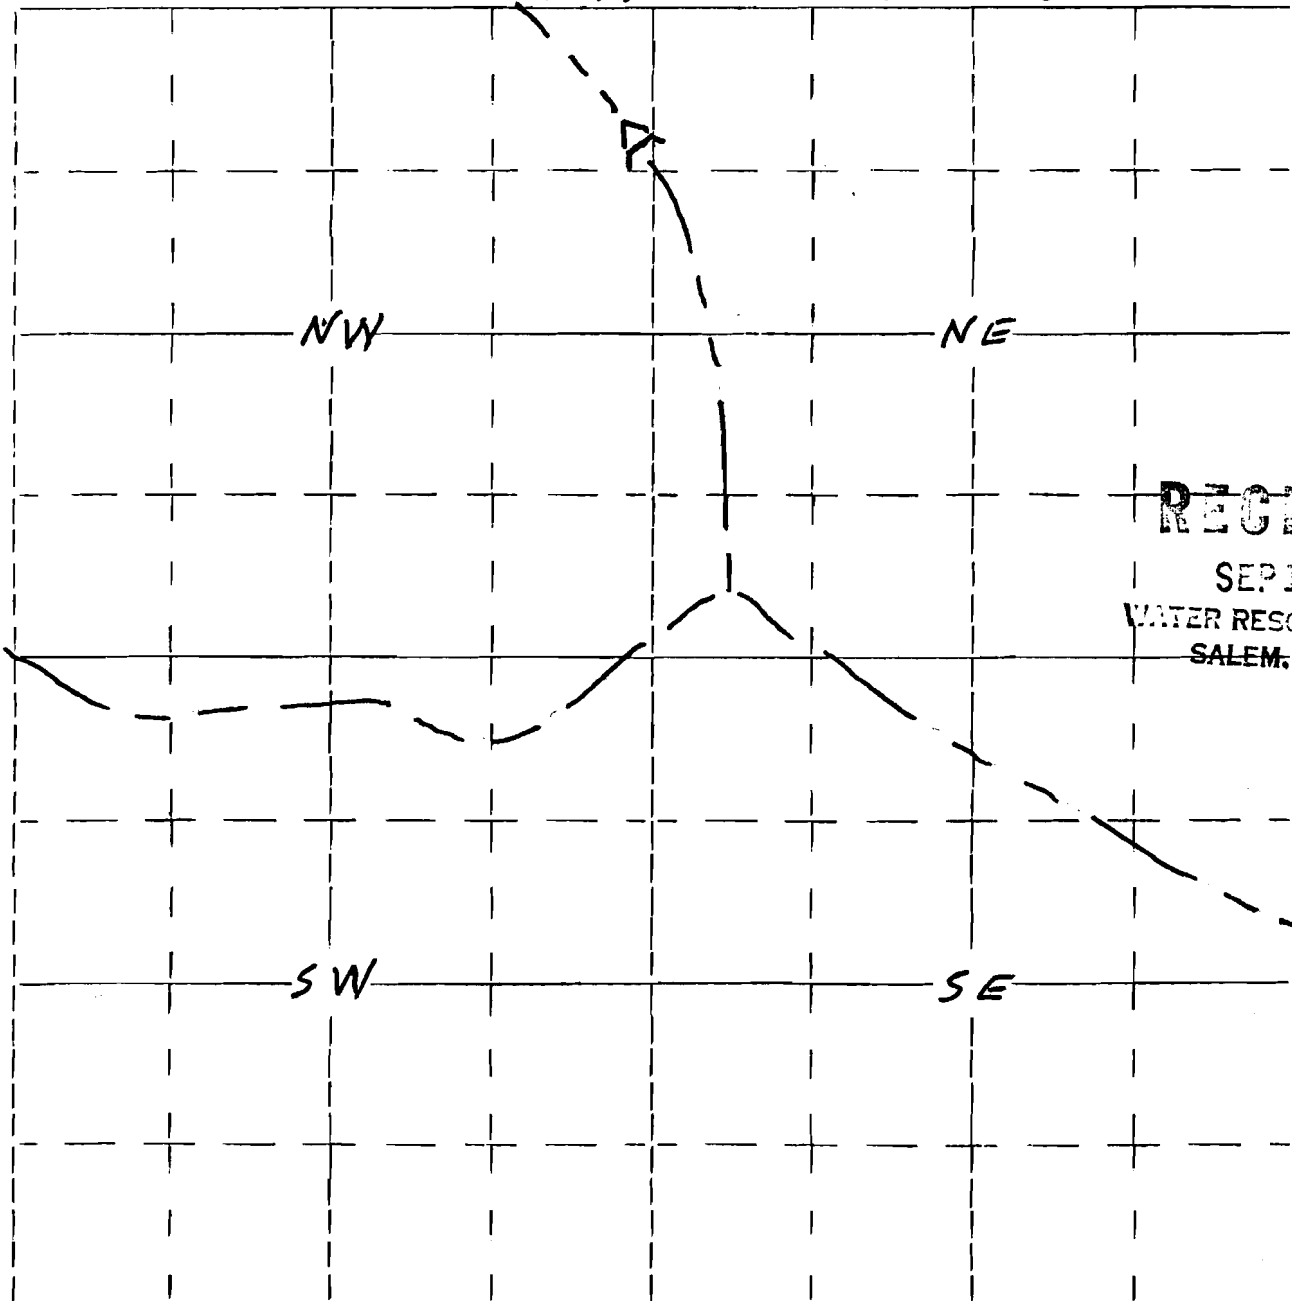

THE DAM IS 180 FT. SOUTH AND 20 FT. WEST
OF THE N $\frac{1}{4}$ COR. OF SEC. 6