

R9825
02632

Form OR-010-7300-2
4/83

UNITED STATES
DEPARTMENT OF THE INTERIOR
BUREAU OF LAND MANAGEMENT


Section 12
SESW

Township 30 S
Range 23 E

Appl. No. R-66088
Permit No. R 9825

Will. Mer.

Gregg Reservoir # 1197

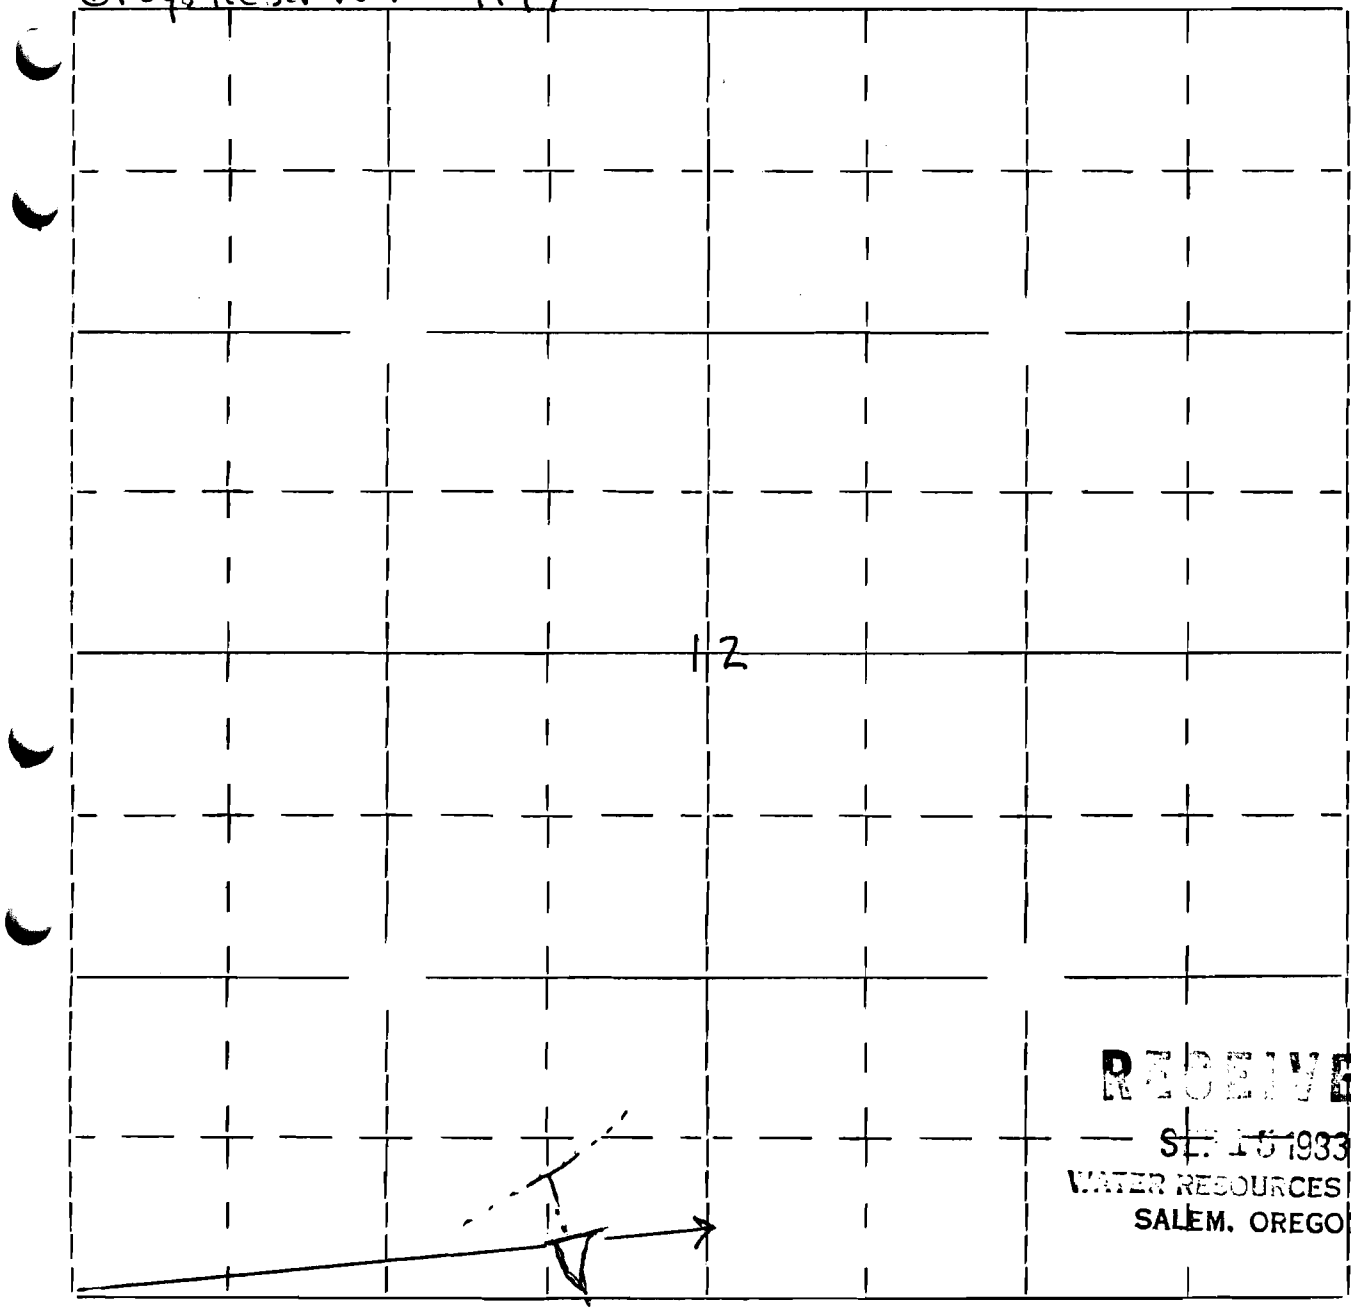

RECEIVED
SEP 15 1933
WATER RESOURCES DEPT.
SALEM, OREGON

2,100' E, 150' N of
SW corner sec. 12