

R9826
62633

Form OR-010-7300-2
4/83

UNITED STATES
DEPARTMENT OF THE INTERIOR
BUREAU OF LAND MANAGEMENT

Section 10
NWSE


Township 28S.
Range 25S

Appl. No. R-66089

Permit No. R 9826

Will. Mer.

#1520 Brink Res.

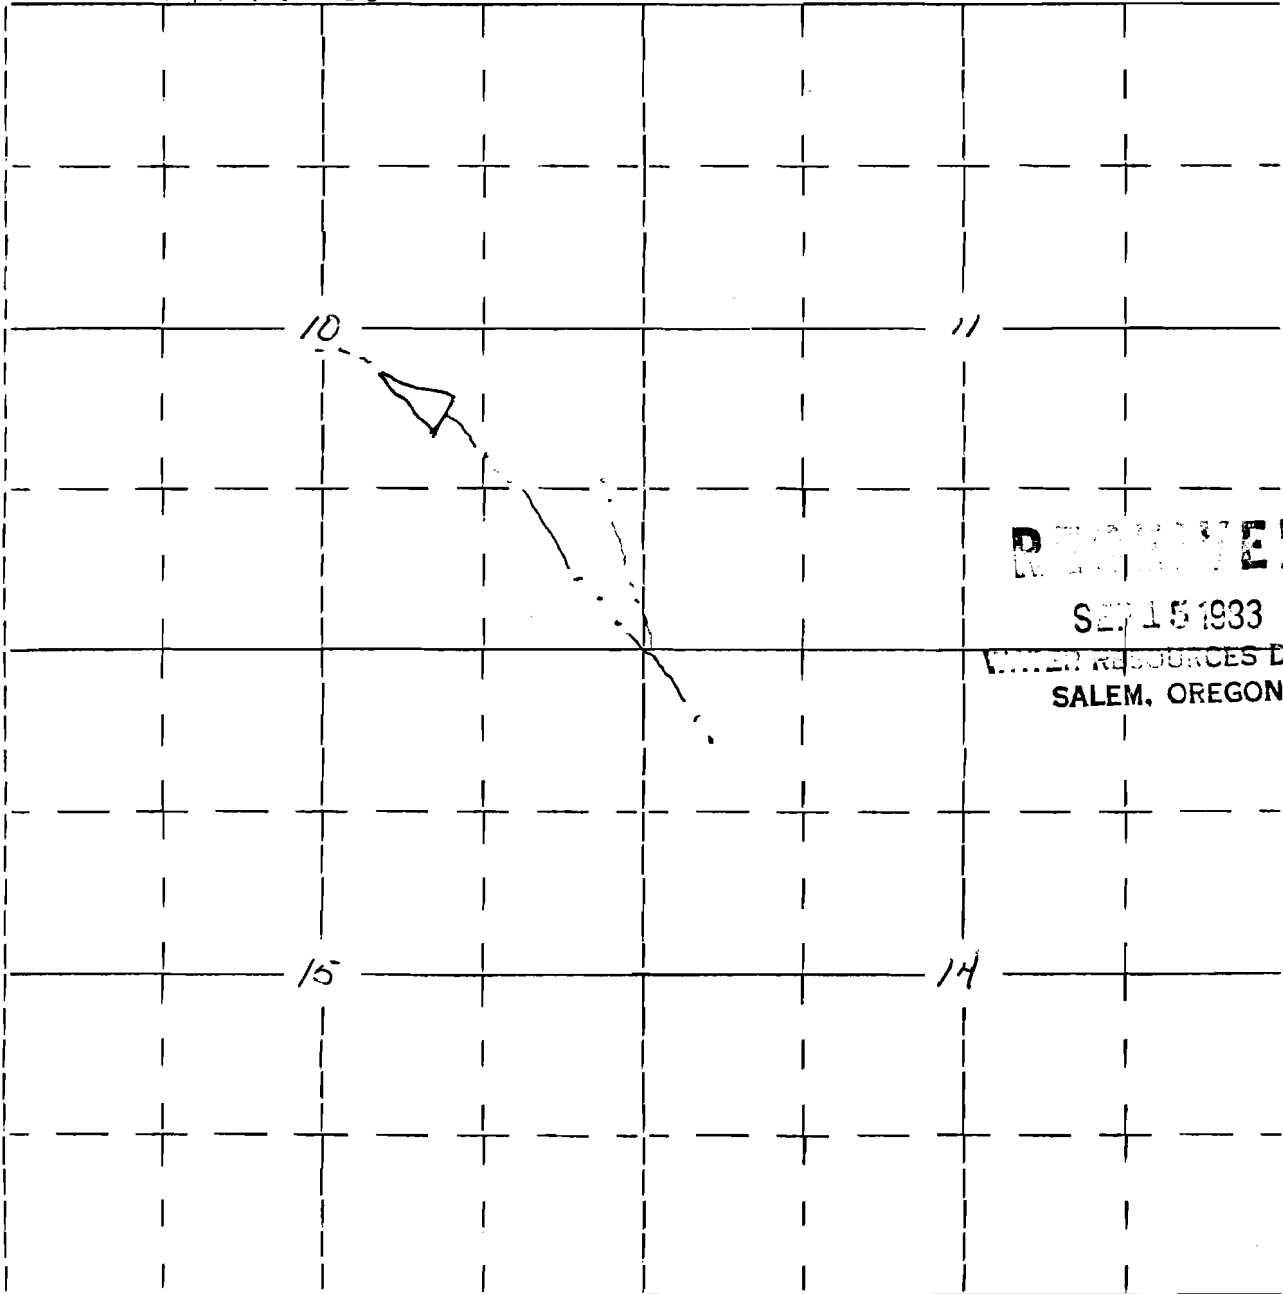

1,900' N, 900' E of $\frac{1}{4}$ corner between secs 10 & 15