

R-9830

(5332) 62634

Form OR-010-7300-2
4/83UNITED STATES
DEPARTMENT OF THE INTERIOR
BUREAU OF LAND MANAGEMENT

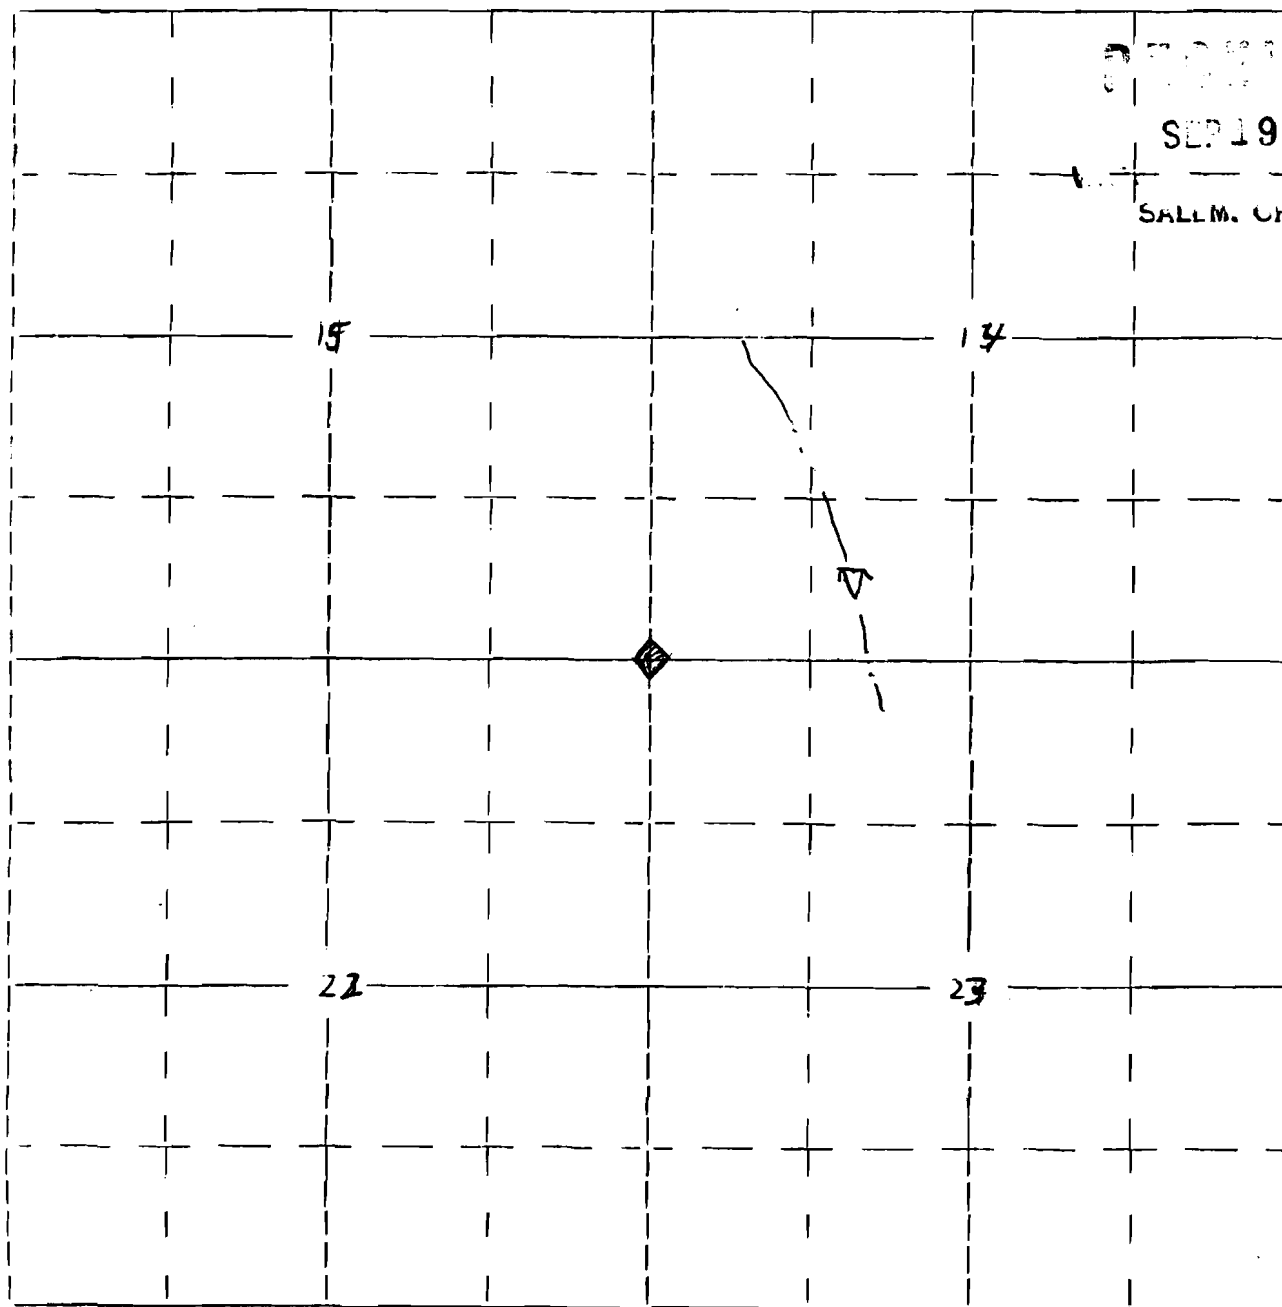
Section

Township 40 S.Appl. No. R-6632514, 15Range 14 E.Permit No. R 983022, 23

Will. Mer.

RECEIVED

SEP 19 1983

BUREAU OF LAND MGMT.
SALMON, OREGON

Project is 1,450' east and 660' north of corner common
to sections 14, 15, 22 & 23.