

R-9831  
(4856) 62635

Form OR-010-7300-2  
4/83

UNITED STATES  
DEPARTMENT OF THE INTERIOR  
BUREAU OF LAND MANAGEMENT

Section

Township 37 S., 38 S.

Appl. No. R-66326


31, 32,

Range 11½ E.

Permit No. R 9831

5 & 6

Will. Mer.

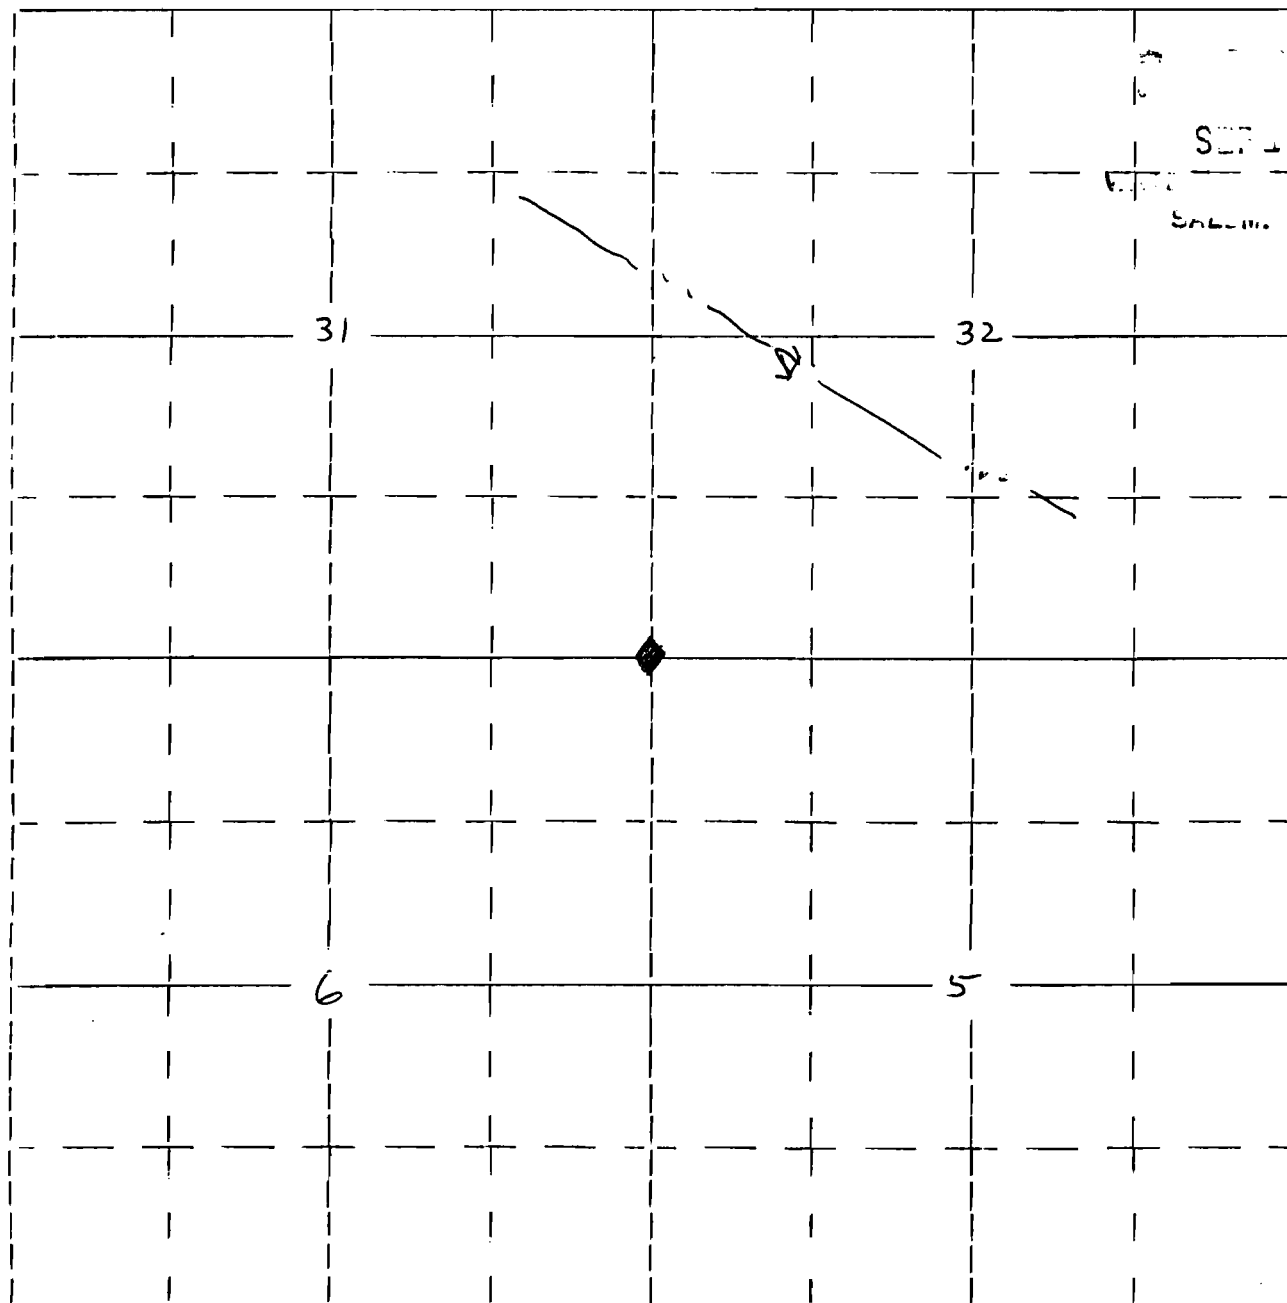

RECEIVED  
SEP 19 1983  
BUREAU OF LAND MGMT.  
DEPT. OF THE INTERIOR  
SALAS, J. LOON

Project is 2,475' north and 1,300' east of corner common to  
sections 31, 32, 5 & 6.