

R-9832
(4331)
62636

Form OR-010-7300-2
4/83

UNITED STATES
DEPARTMENT OF THE INTERIOR
BUREAU OF LAND MANAGEMENT

Section

Township 38 S.

Appl. No. R-66327

9, 10, 15 & 16

Range 11 1/2 E.


Permit No. R 9832

Will. Mer.

RECEIVED

SEP 19 1983

V.L.D. DEPT.
SALEM, OREGON

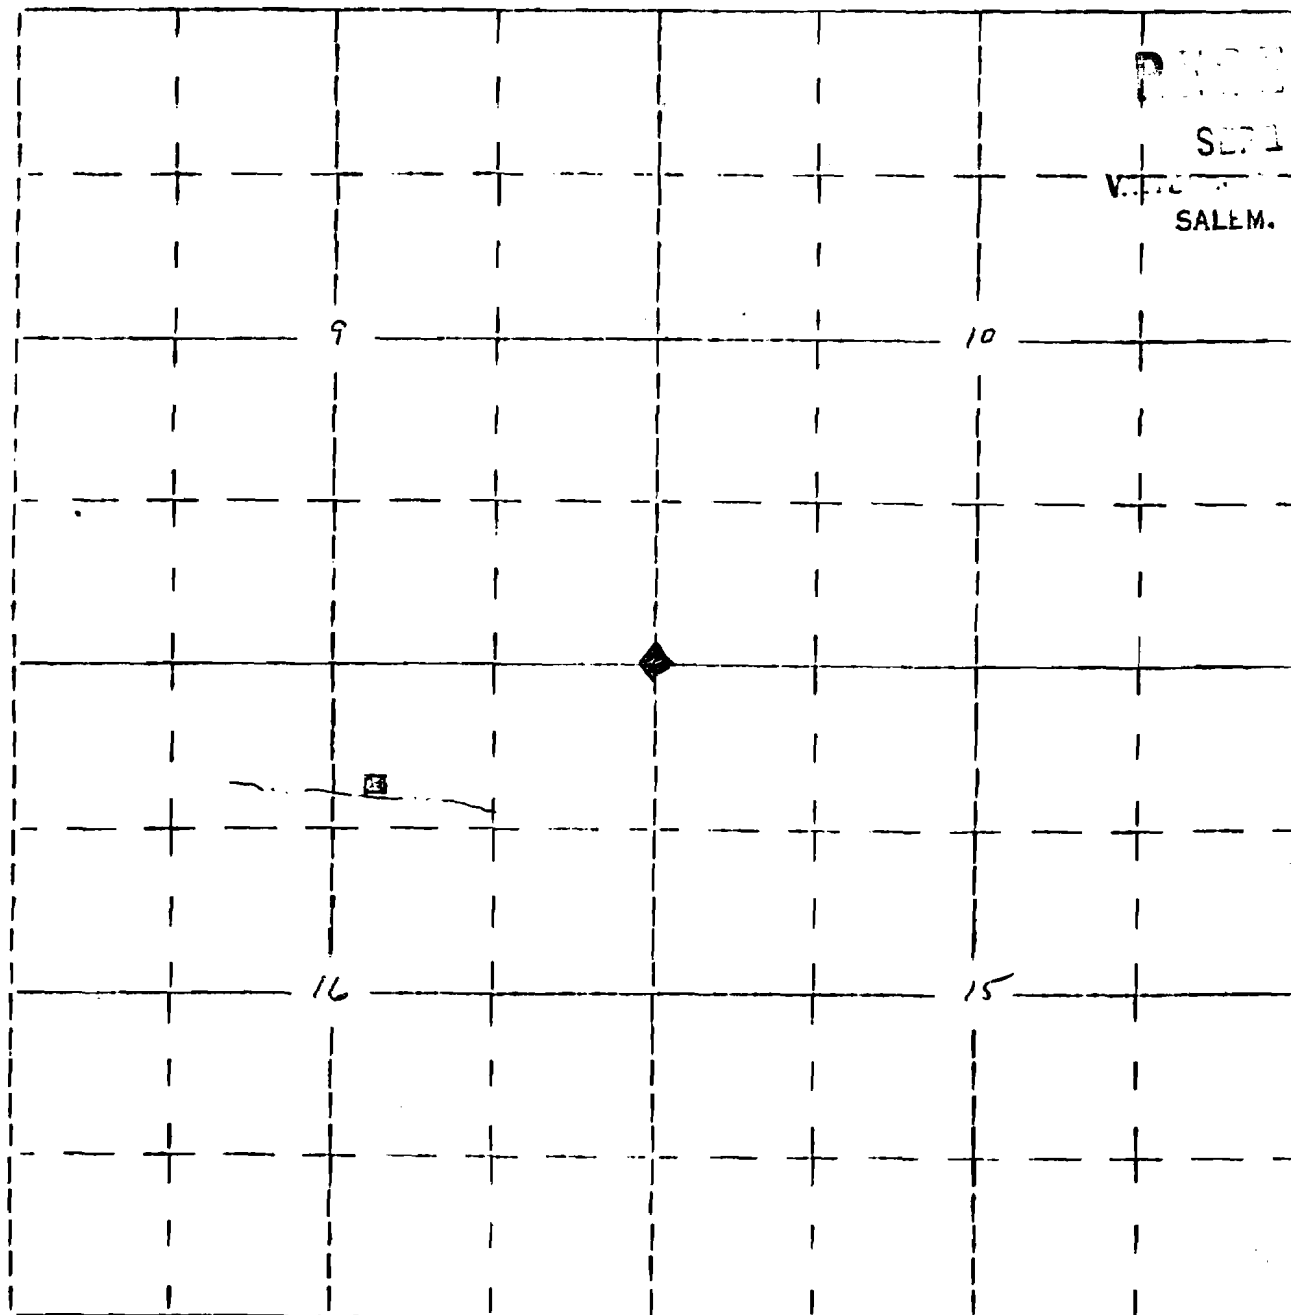

Project is 2,310' west and 990' south of corner common
to sections 9, 10, 15 & 16.