

R-9833
(62637)
(5036)

Form DR-010-7300-2
4/83

UNITED STATES
DEPARTMENT OF THE INTERIOR
BUREAU OF LAND MANAGEMENT

Section

Township 40 S


Appl. No. R-66328

13, 14, 23 & 24

Range 14 E

Permit No. R 9833

Will. Mer.

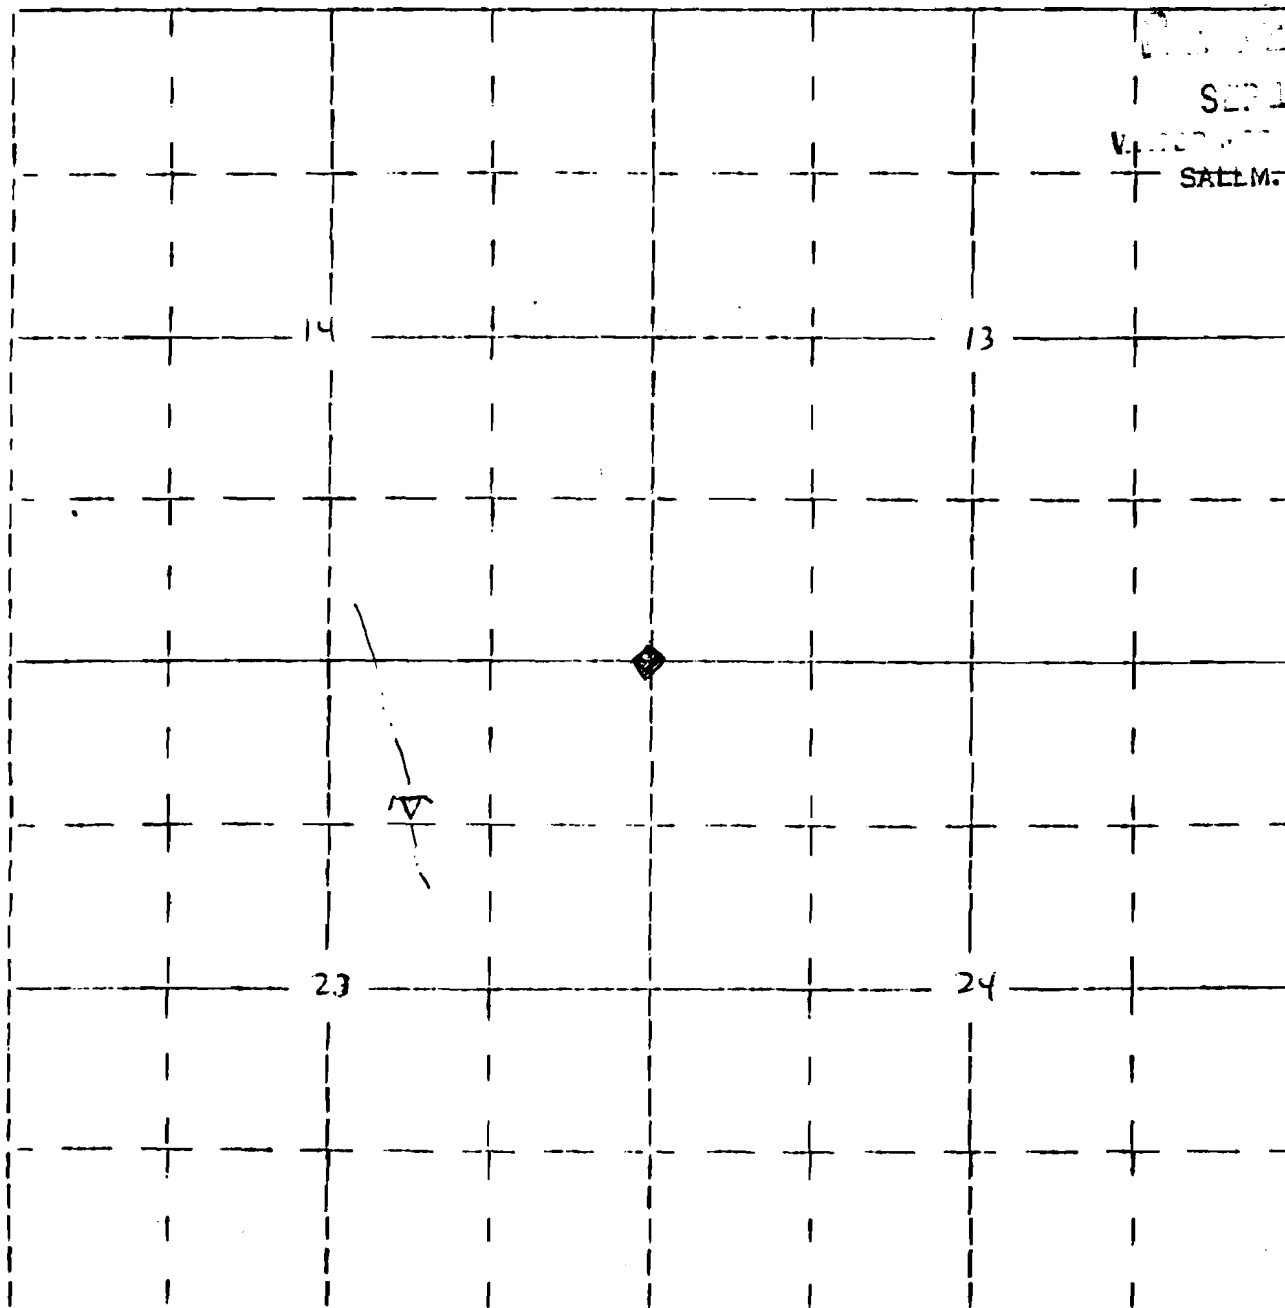

RECEIVED
SEP 19 1993
SALTM. OREGON

Project is 1,980' west and 1,155' south of corner common
to Sections 13, 14, 23 & 24.