

R-9835
(4330)
62639

Form OR-010-7300-2
4/83

UNITED STATES
DEPARTMENT OF THE INTERIOR
BUREAU OF LAND MANAGEMENT

Section

Township 37 S.

Appl. No. R-66330

29, 30, 31 & 32


Range 11 1/2 E.

Permit No. R-9835

Will. Mer.

SEP 19 1983

U.S. DEPT.
SALEM, OREGON

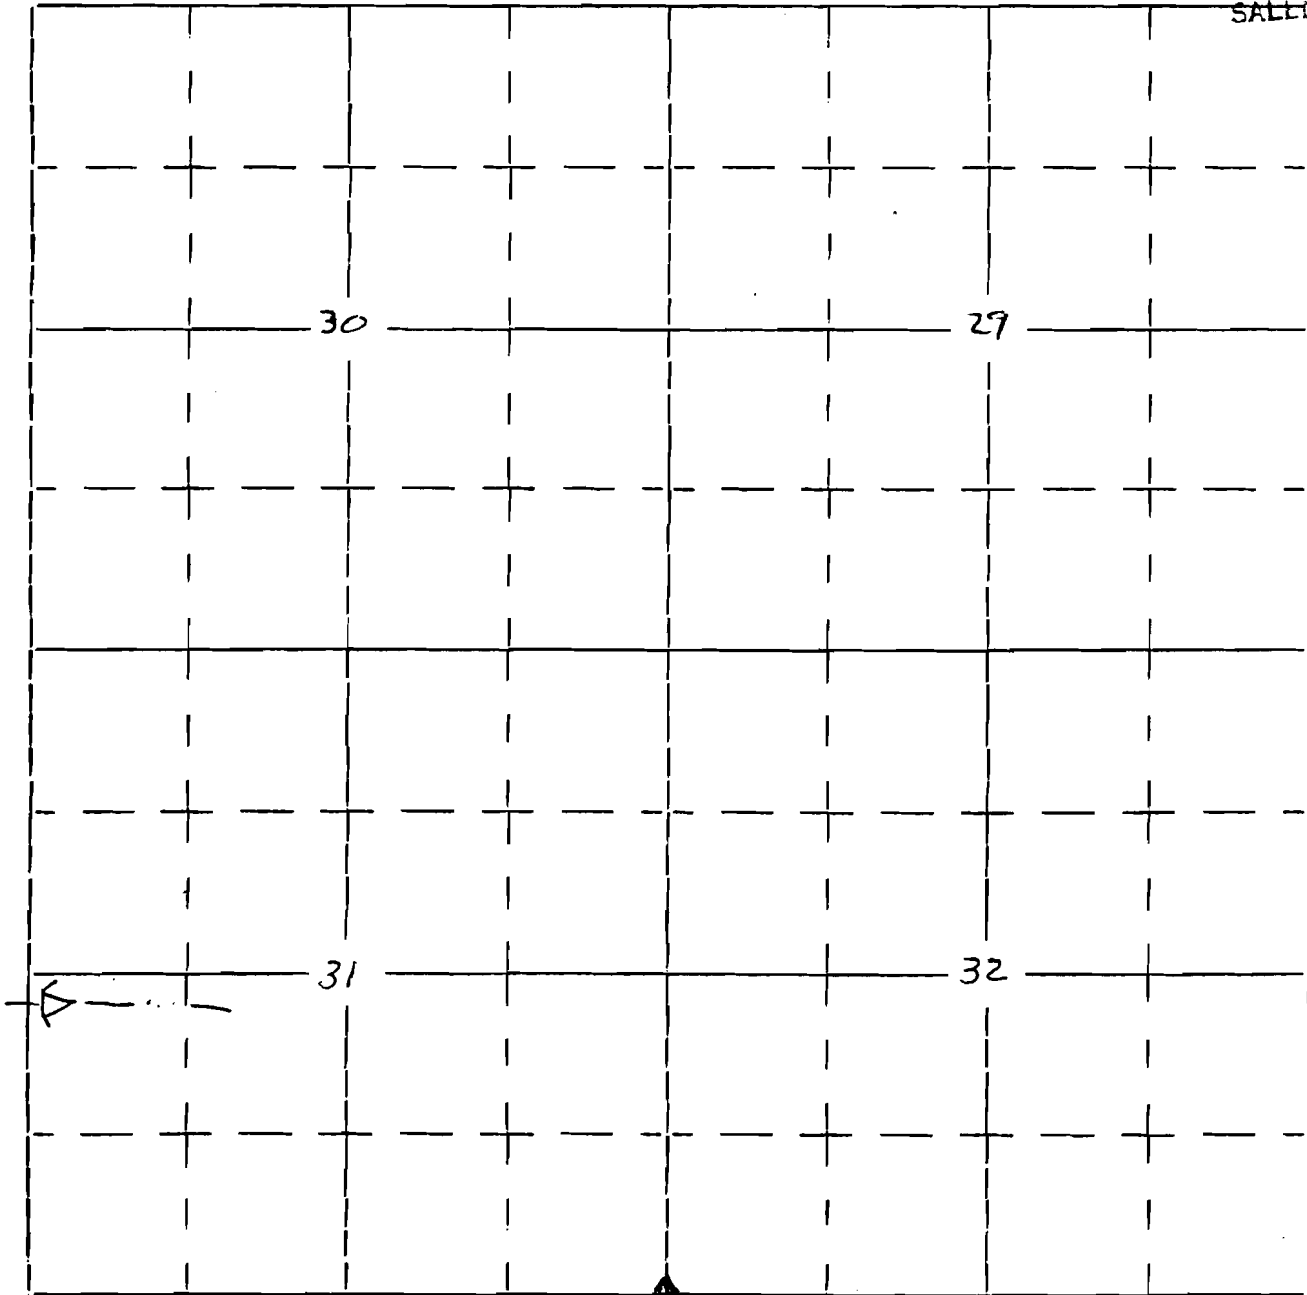

Project is located 3,795' West and 2,145' North of section
corner common to 31, 32, 5 & 6.