

Form OR-010-7300-2
4/83

UNITED STATES
DEPARTMENT OF THE INTERIOR
BUREAU OF LAND MANAGEMENT

Section

6

NE NW

Township 41 S.

41 S.

Range 26 E.

26 E.


Will. Mer.

RECEIVED
OCT 3 1983
WATER RESOURCES DEPT.
SALEM, OREGON
Appl. No. 109
Permit No.

Appl. No.

Permit No.

Burn Spring Res # 066A

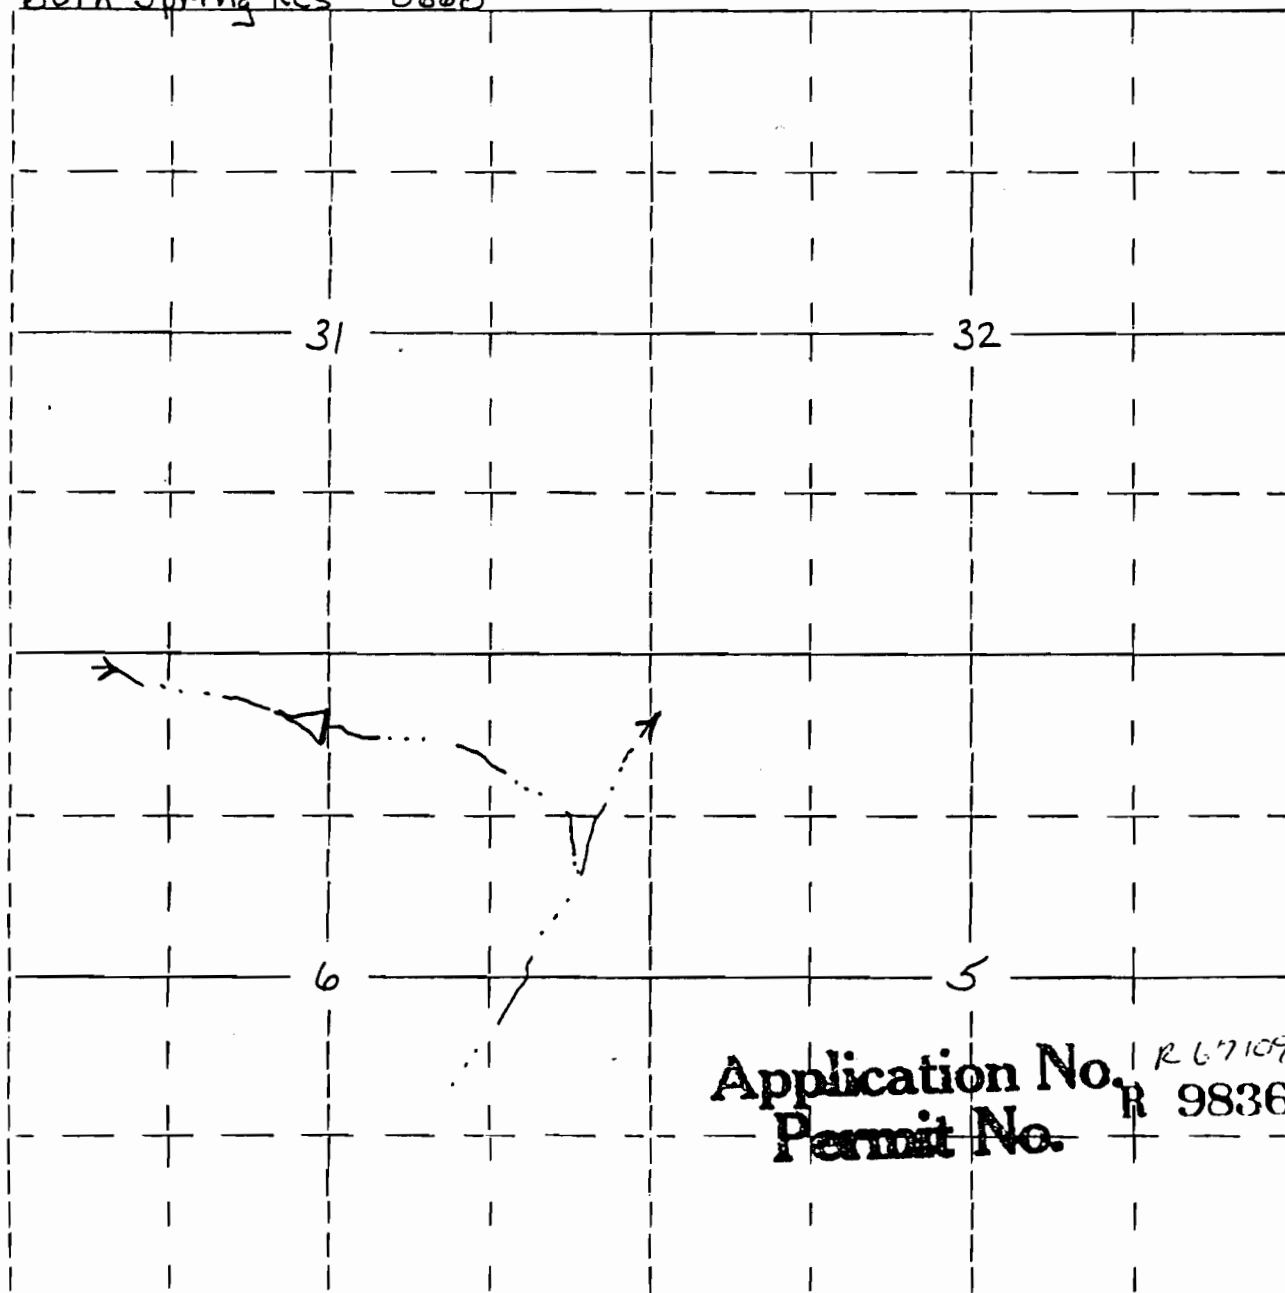

Application No. _____
Permit No. _____

R 67109
9836

700'S., 2,600' E., of NW corner of section 6.