

R9842
62641

Form OR-010-7300-2
4/83

UNITED STATES
DEPARTMENT OF THE INTERIOR
BUREAU OF LAND MANAGEMENT


Section

1
T395
R 23E

Solomon
5350

Appl. No. R-67115

Permit No. R 9842

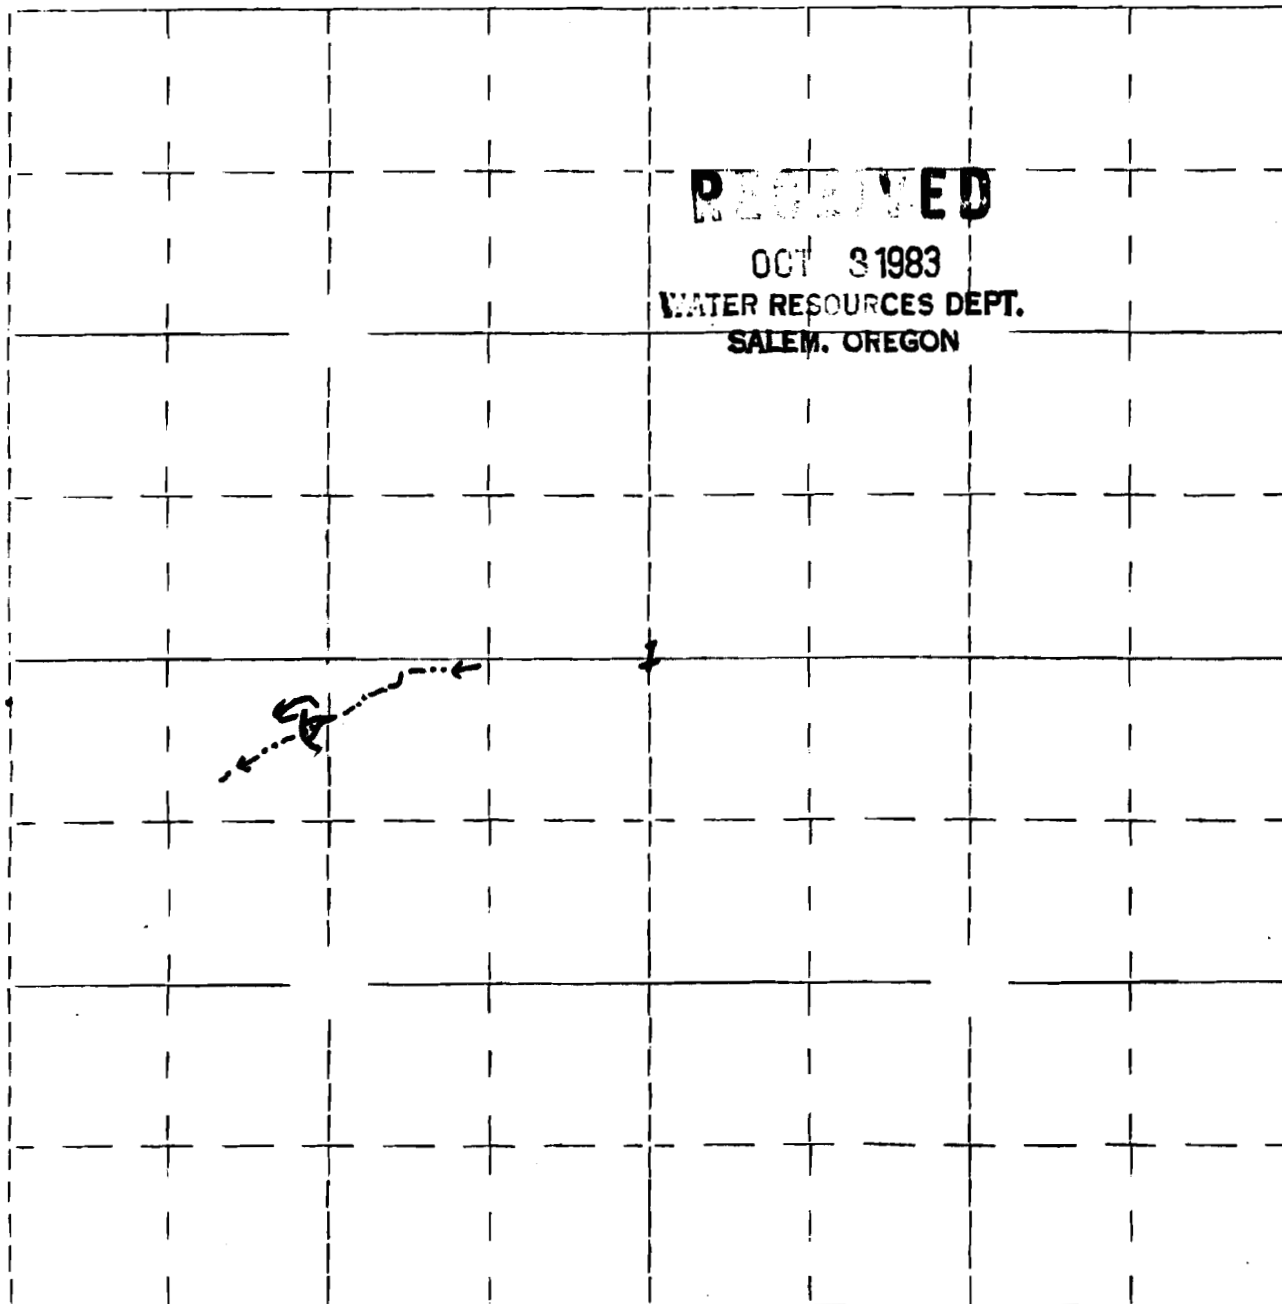

2450' north & 1300' East of the
SW corner of sec. 1.