

R9845
62643

Form OR-010-7300-2
4/83

UNITED STATES
DEPARTMENT OF THE INTERIOR
BUREAU OF LAND MANAGEMENT

Section

31

Township 40S

Appl. No. R-67112


SE NW

Range 26E

Permit No. R 9845

Will. Mer.

Sack Seep Res # 0702

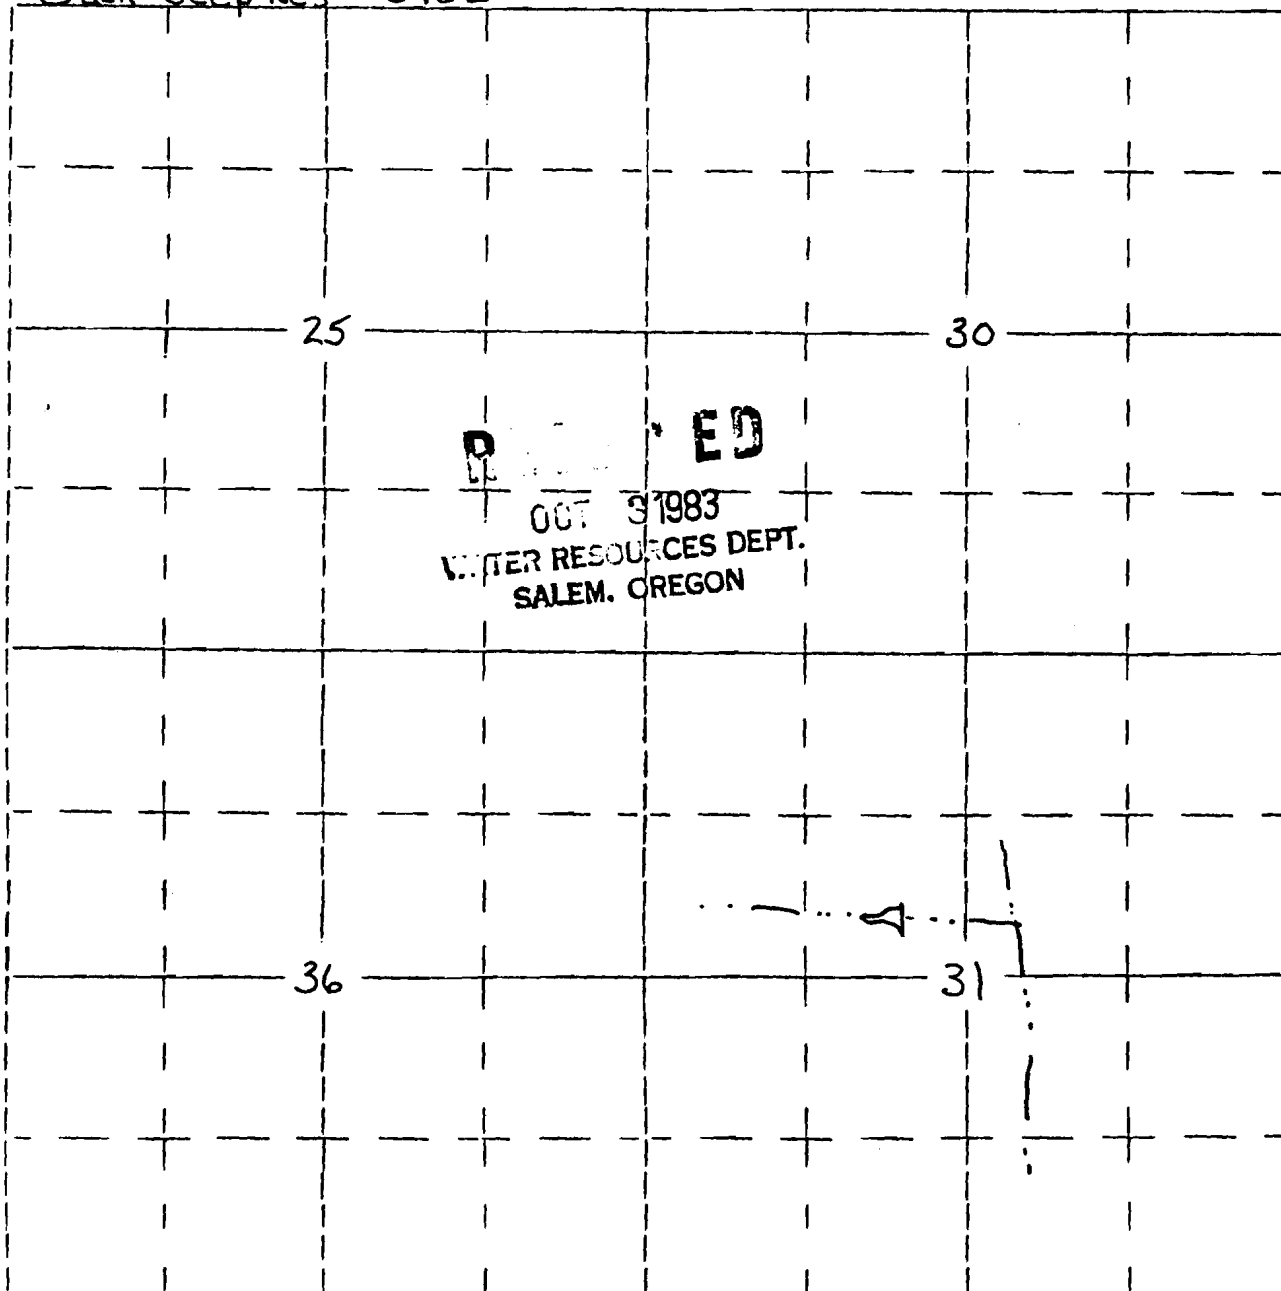

2200'S., 2500'E., of NW corner section 31.