

R9846
62644

OR-010-7300-2
4/83

UNITED STATES
DEPARTMENT OF THE INTERIOR
BUREAU OF LAND MANAGEMENT

Section

29

Township

40S

Appl. No.

R-67119

NE NE

Range


26E

Permit No.

R 9846

Will. Mer.

Broken Arrow Res. #0806

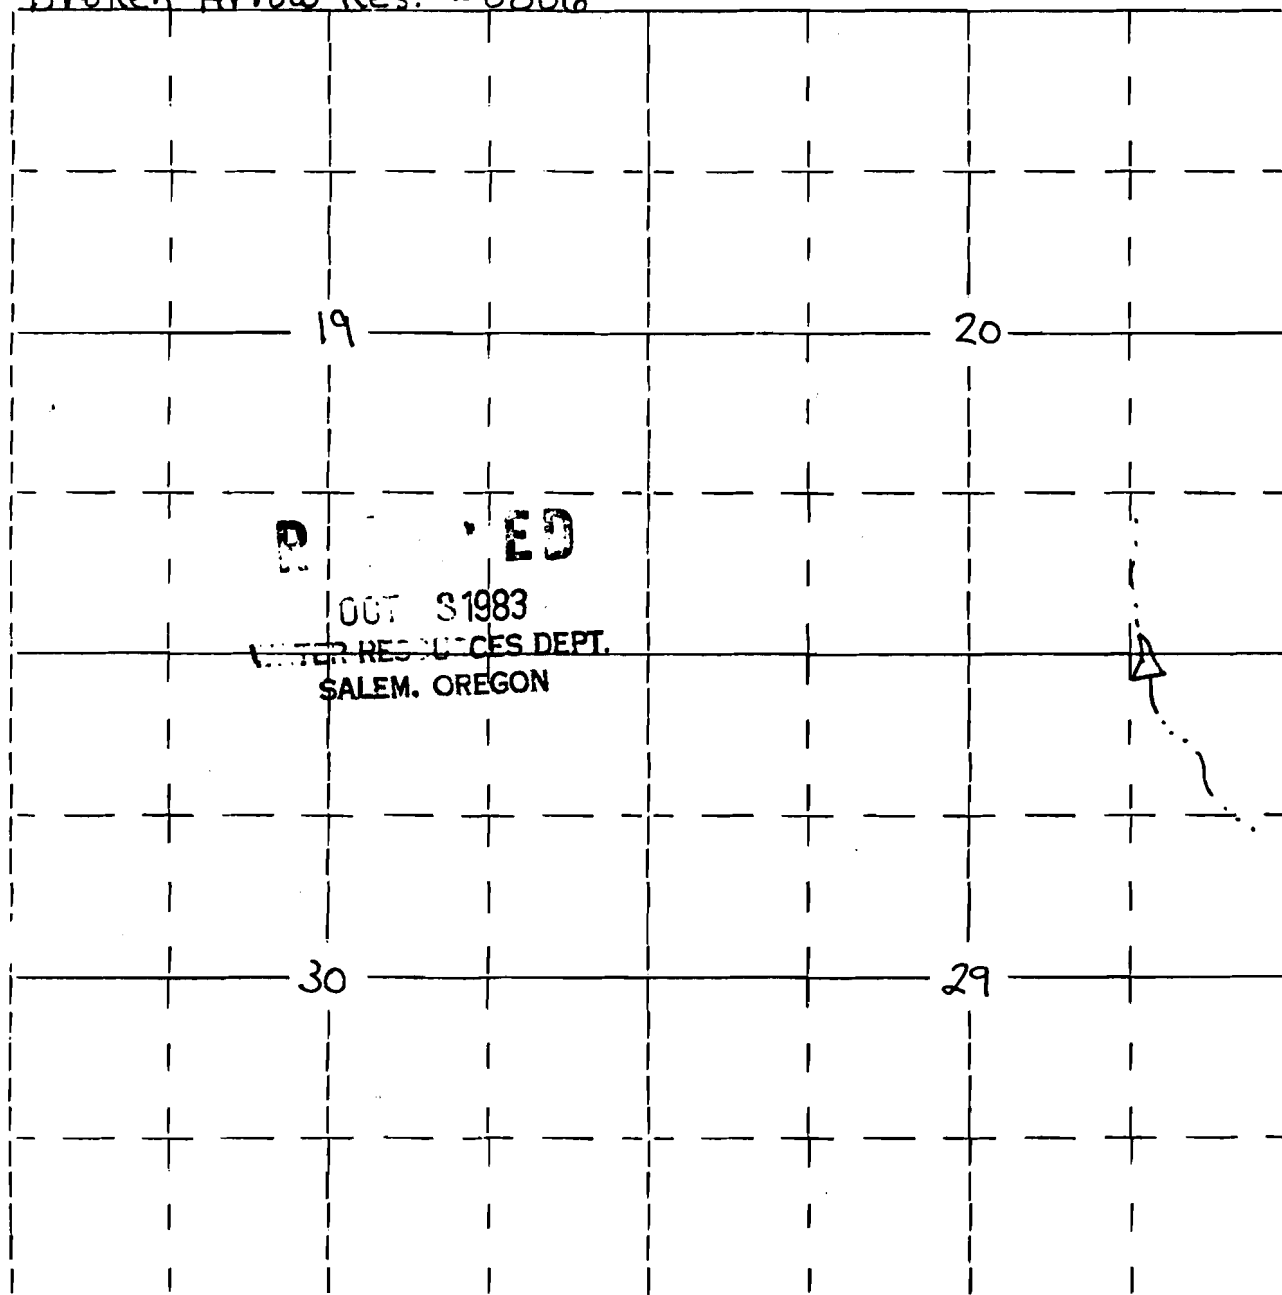

230 'S., 1,160' W., of NE corner section 29