

R 9848
62646

Form OR-010-7300-2
4/83

UNITED STATES
DEPARTMENT OF THE INTERIOR
BUREAU OF LAND MANAGEMENT

Section

26

Township 40S.

Appl. No. R-67121


SESE

Range 22E.

Permit No. R 9848

Will. Mer.

Lee W.H. Res #4054

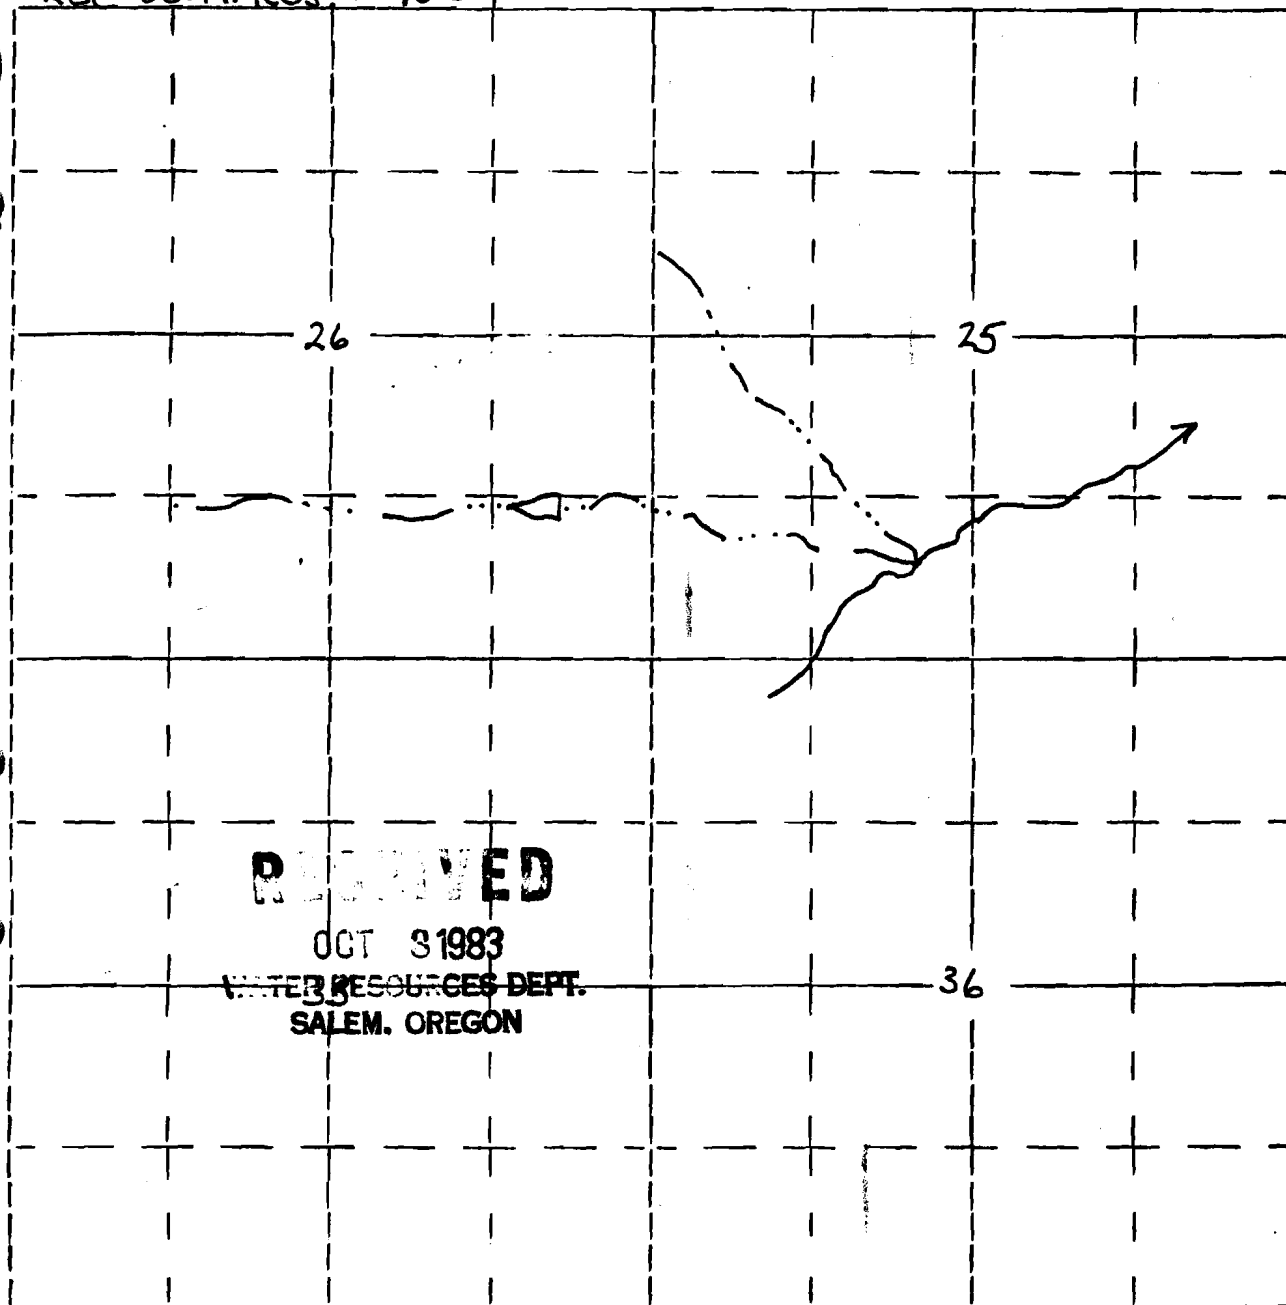

1300 'N., 800 'W., of SE corner of section 26