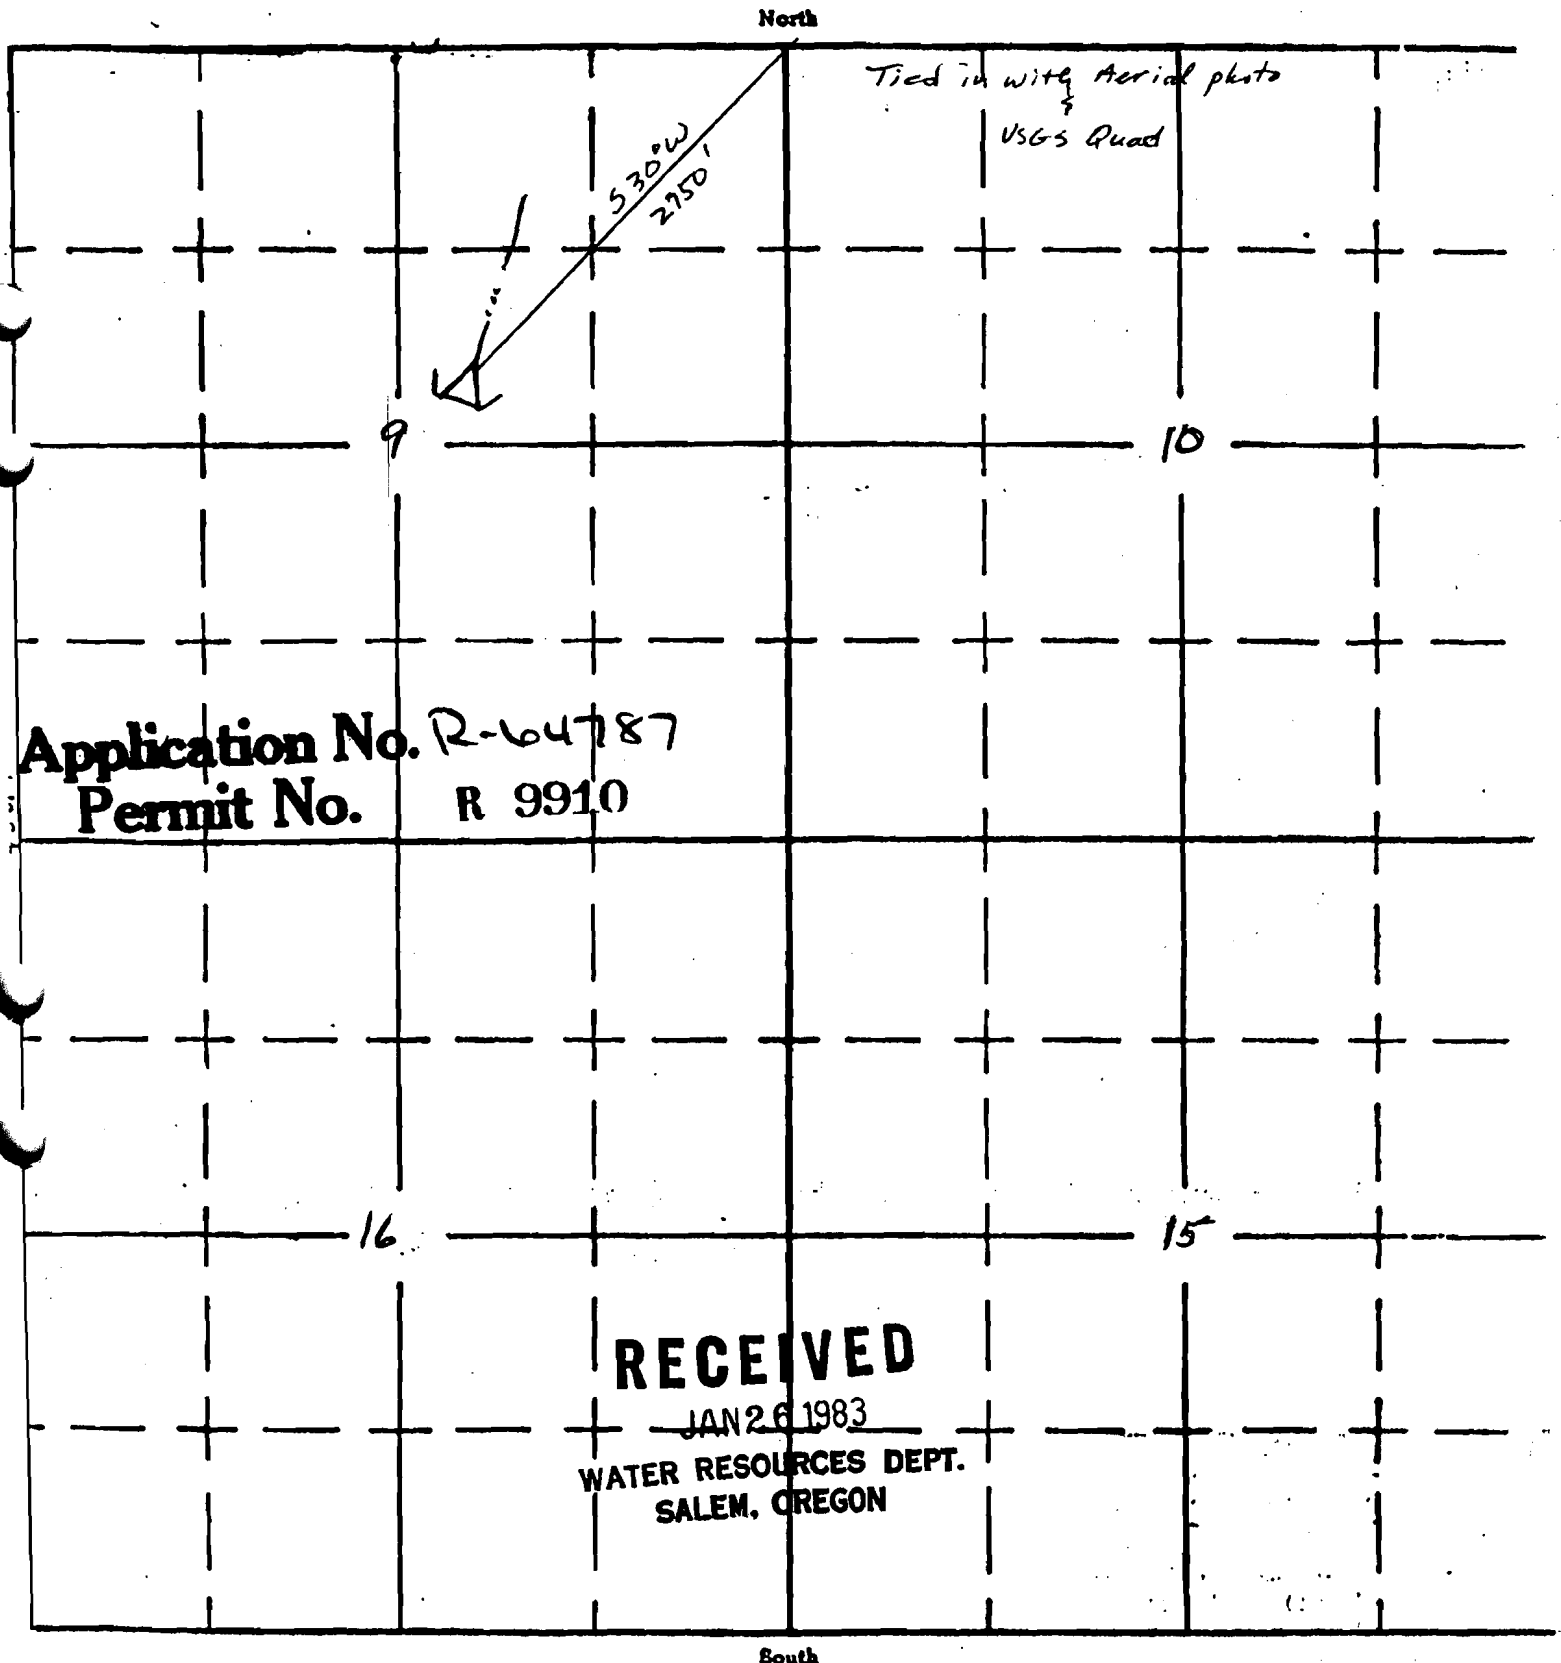


SECTION

Oregon State Water Filings

TOWNSHIP 41 S., RANGE 14 1/2 E., W. M.

APPLICATION No.