

(6119)

Form OR-010-7300-2
4/83

UNITED STATES
DEPARTMENT OF THE INTERIOR
BUREAU OF LAND MANAGEMENT

Section

Township 39 S.

Appl. No. R-65991


14, 15, 22 & 23

Range 10 E.

Permit No. R10723

Will. Mer.

Application No.
Permit No.

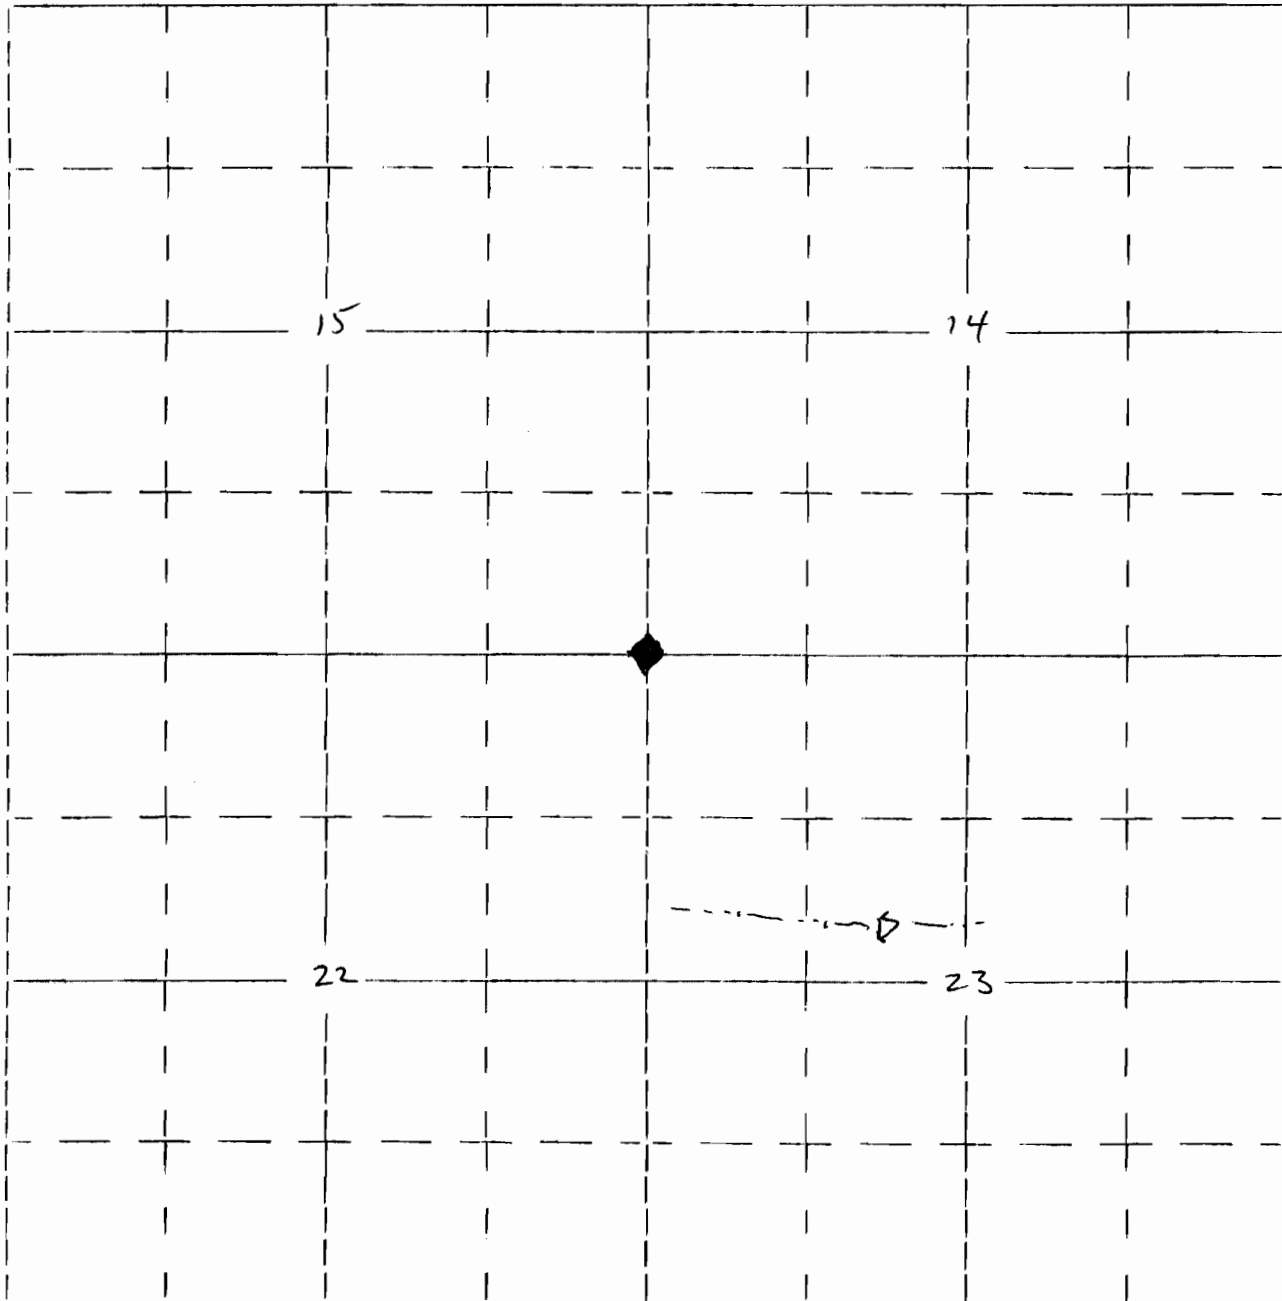

Project located 2,145' south and 190' east of corner common to
Sections 14, 15, 22 & 23.

RECEIVED
SEP 9 1983
WATER RESOURCES DEPT.
SALEM, OREGON