

R 10724
(0119) 62658
1 of 2

Form OR-010-7300-2
4/83

UNITED STATES
DEPARTMENT OF THE INTERIOR
BUREAU OF LAND MANAGEMENT

Section

Township 39 S.

Appl. No. R-65991


14, 15, 22 & 23

Range 10 E.

Permit No. R-10724

Will. Mer.

Application No.
Permit No.

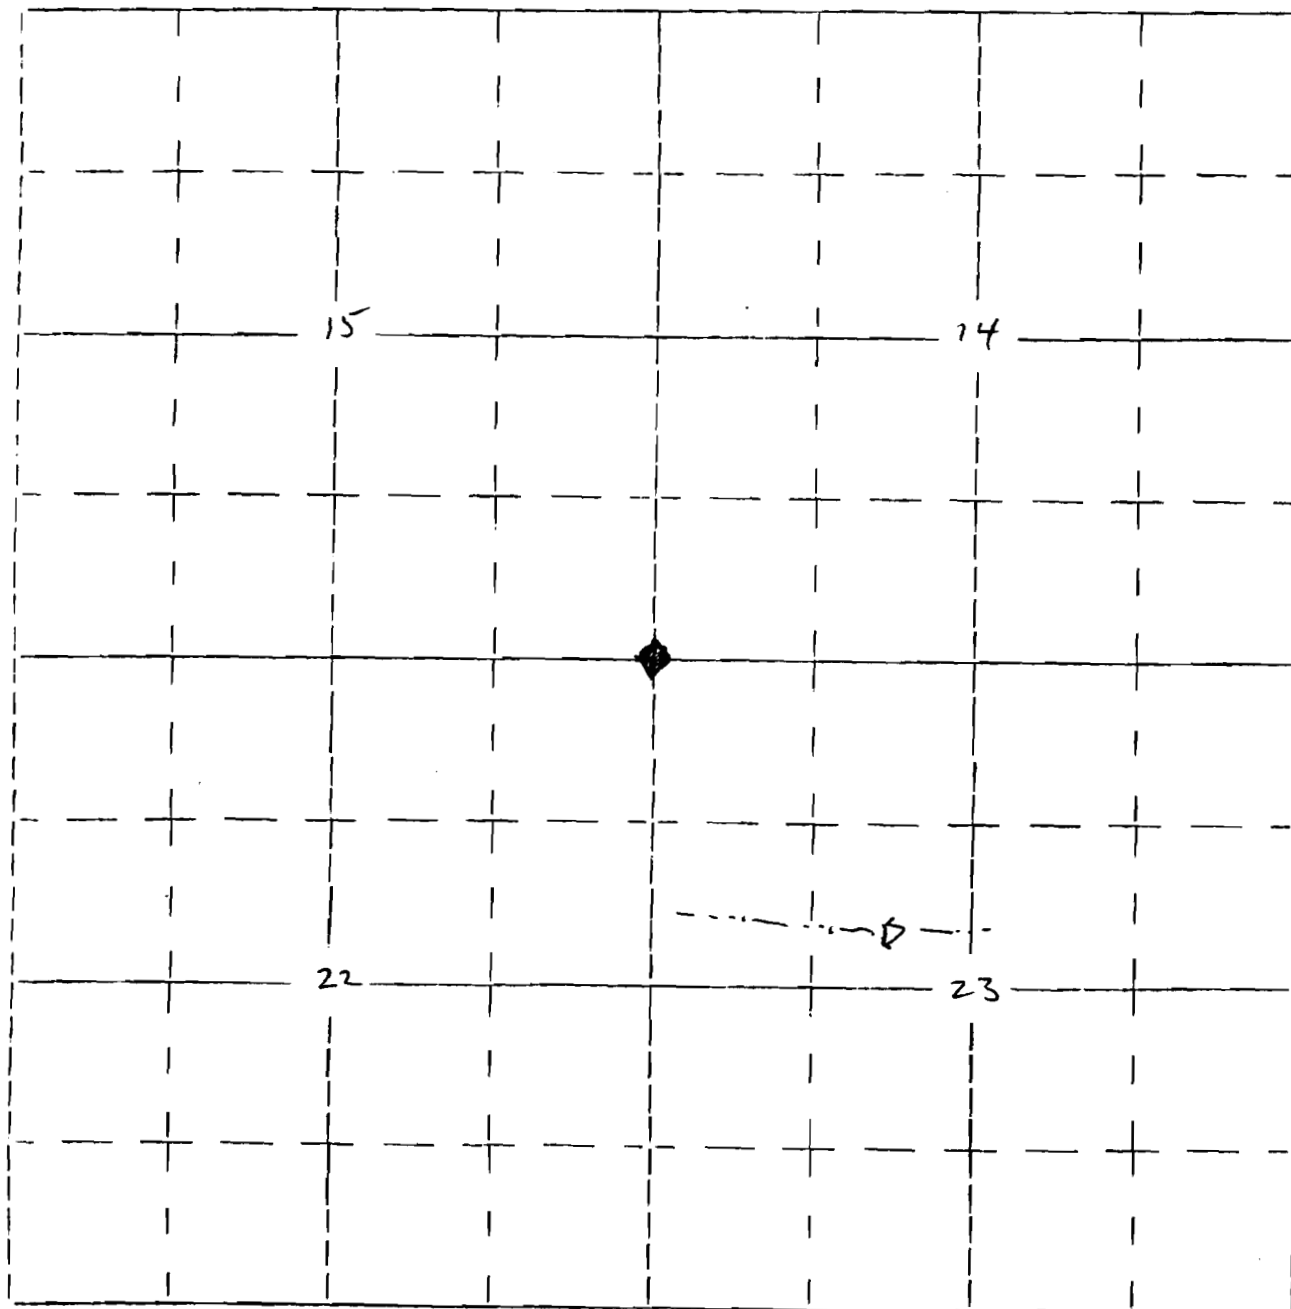

Project located 2,145' south and 190' east of corner common to
Sections 14, 15, 22 & 23.

RECEIVED
SEP 9 1983
WATER RESOURCES DEPT.
SALEM, OREGON

R10724
(5220)

2af2

Form OR-010-7300-2
4/83

UNITED STATES
DEPARTMENT OF THE INTERIOR
BUREAU OF LAND MANAGEMENT

Section

4, 5, 8 & 9

Township 41 S.


Range 14 E.

Will. Mer.

Appl. No. R-68992

Permit No. R10724

Application No.
Permit No.

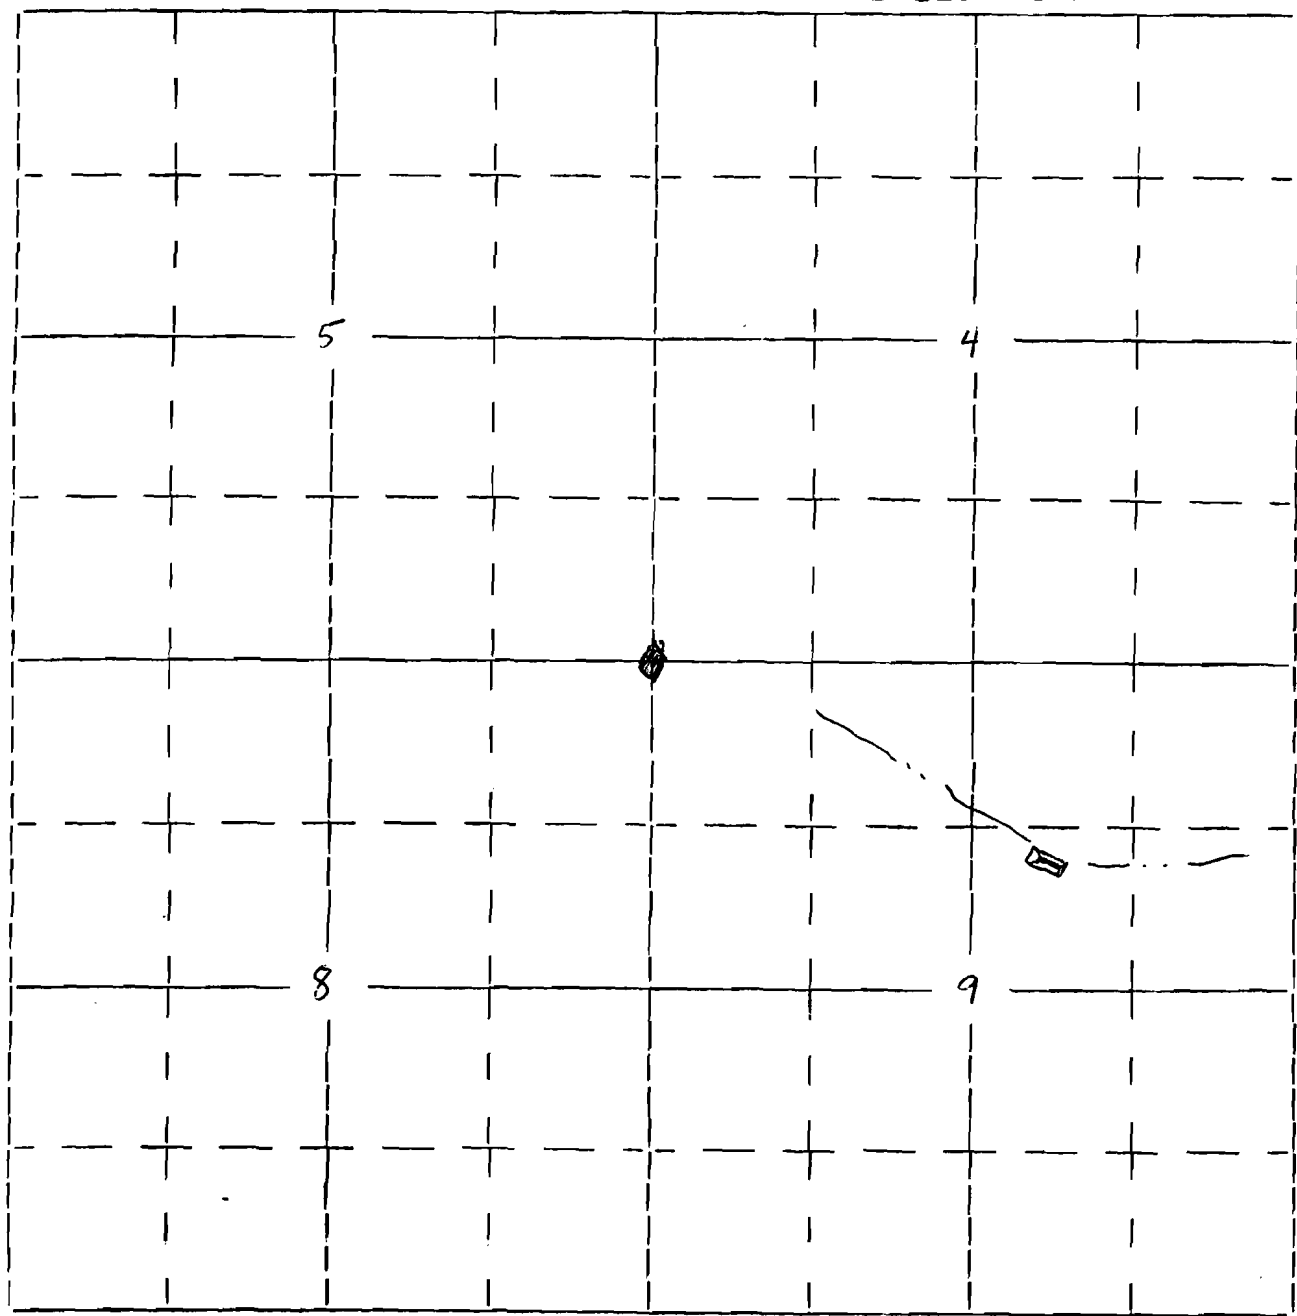

Project located 1375' south and 3,093 east of common
to sections 4, 5, 8 & 9.

RECEIVED
SEP 9 1983
WATER RESOURCES DEPT.
SALEM, OREGON