

770100
(5199)
62659

Form OR-010-7300-2
4/83

UNITED STATES
DEPARTMENT OF THE INTERIOR
BUREAU OF LAND MANAGEMENT

Section

Township 41 S.

Appl. No. R-65993


10, 11, 14 & 15

Range 14 E.

Permit No. R10725

Will. Mer.

Application No.
Permit No.

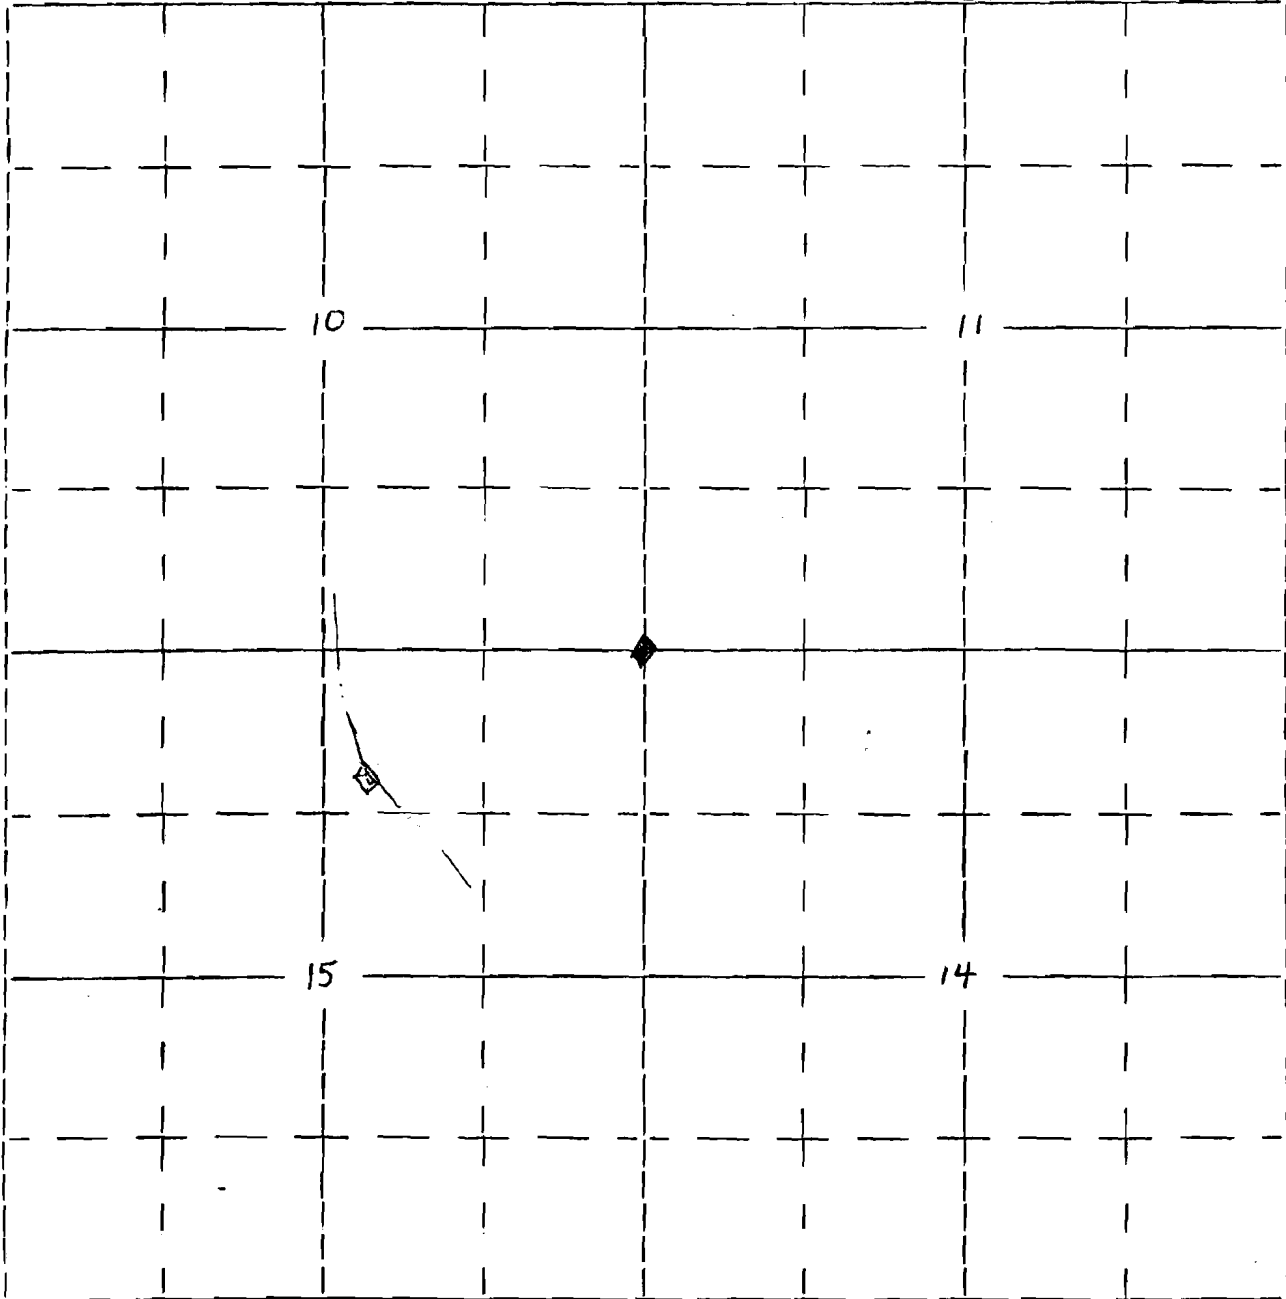

Project is located 2,145' West and 825' south of corner common to
sections 10, 11, 14 & 15.

RECEIVED

SEP 9 1993
WATER RESOURCES DEPT.