

K-10726
62660

Form OR-010-7300-2
4/83

UNITED STATES
DEPARTMENT OF THE INTERIOR
BUREAU OF LAND MANAGEMENT

Section

Township 40 S.

Appl. No. R-65994


3, 4, 9, 10

Range 12 E.

Permit No. R10726

Will. Mer.

Application No.
Permit No.

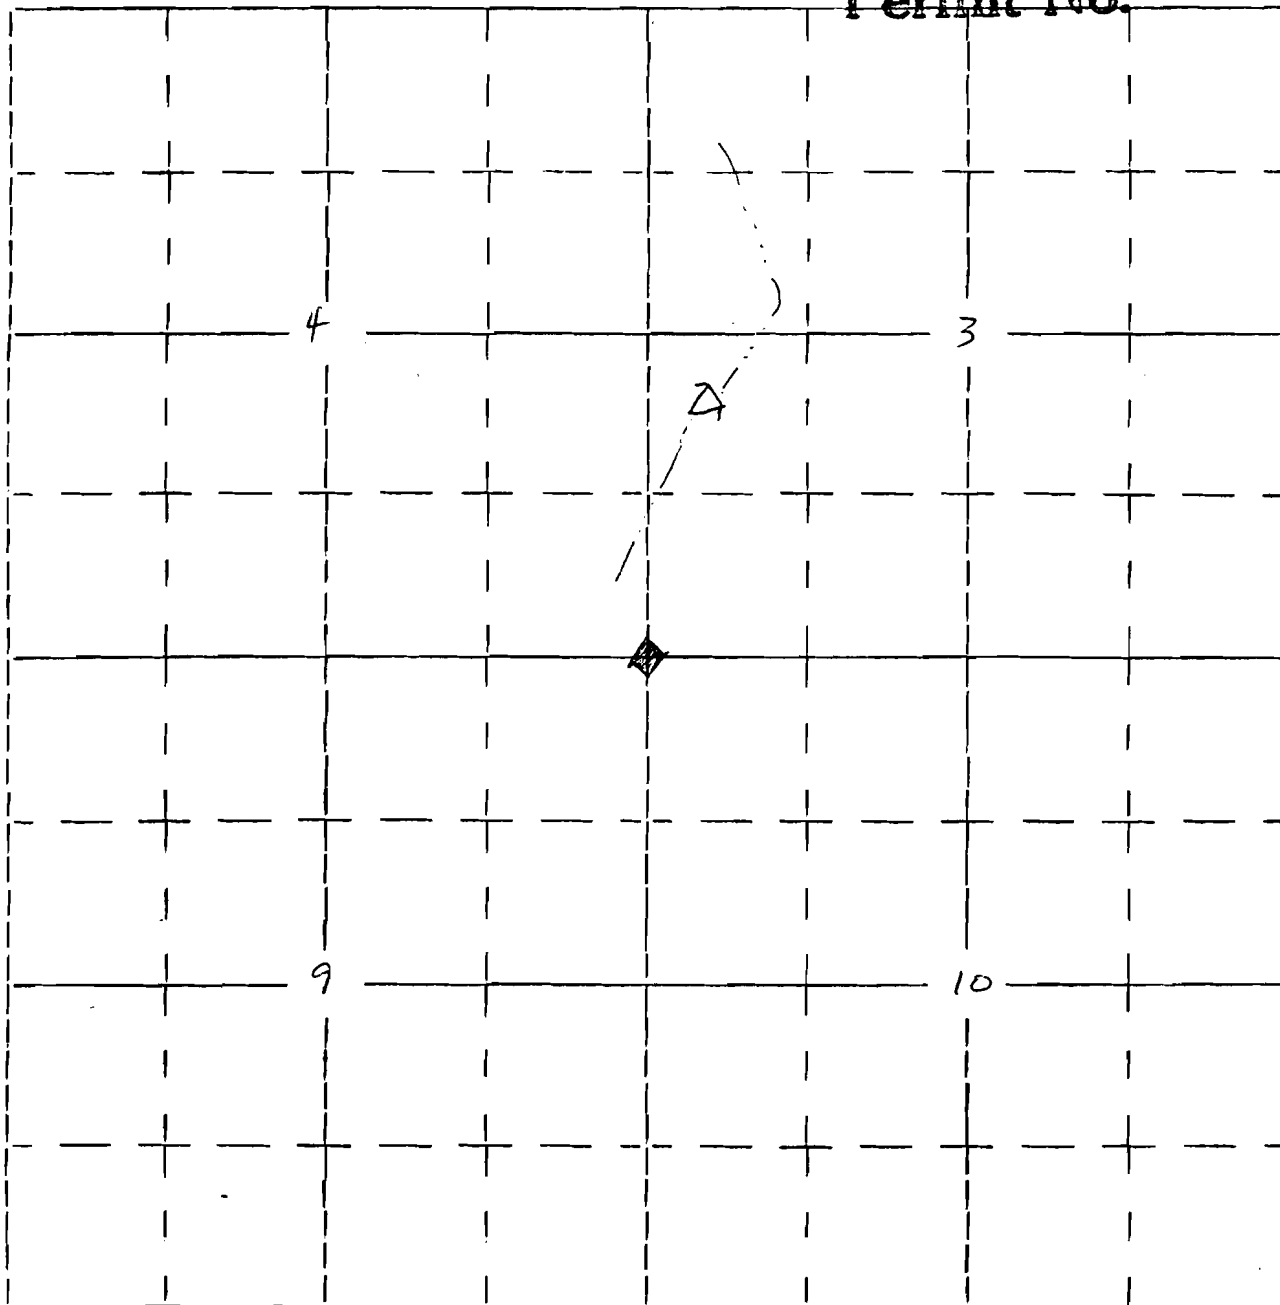

Project is located 2,145' north and 495' east of corner common to sections
3, 4, 9, 10.

RECEIVED

SEP 9 1993
WATER RESOURCES DEPT.
SALEM, OREGON