

R-10727
(4882) 62661

Form OR-010-7300-2
4/83

UNITED STATES
DEPARTMENT OF THE INTERIOR
BUREAU OF LAND MANAGEMENT

Section

Township 38 S.

Appl. No. R-65995


16, 17, 20 & 21

Range 11 1/2 E.

Permit No. R10727

Will. Mer.

Application No.
Permit No.

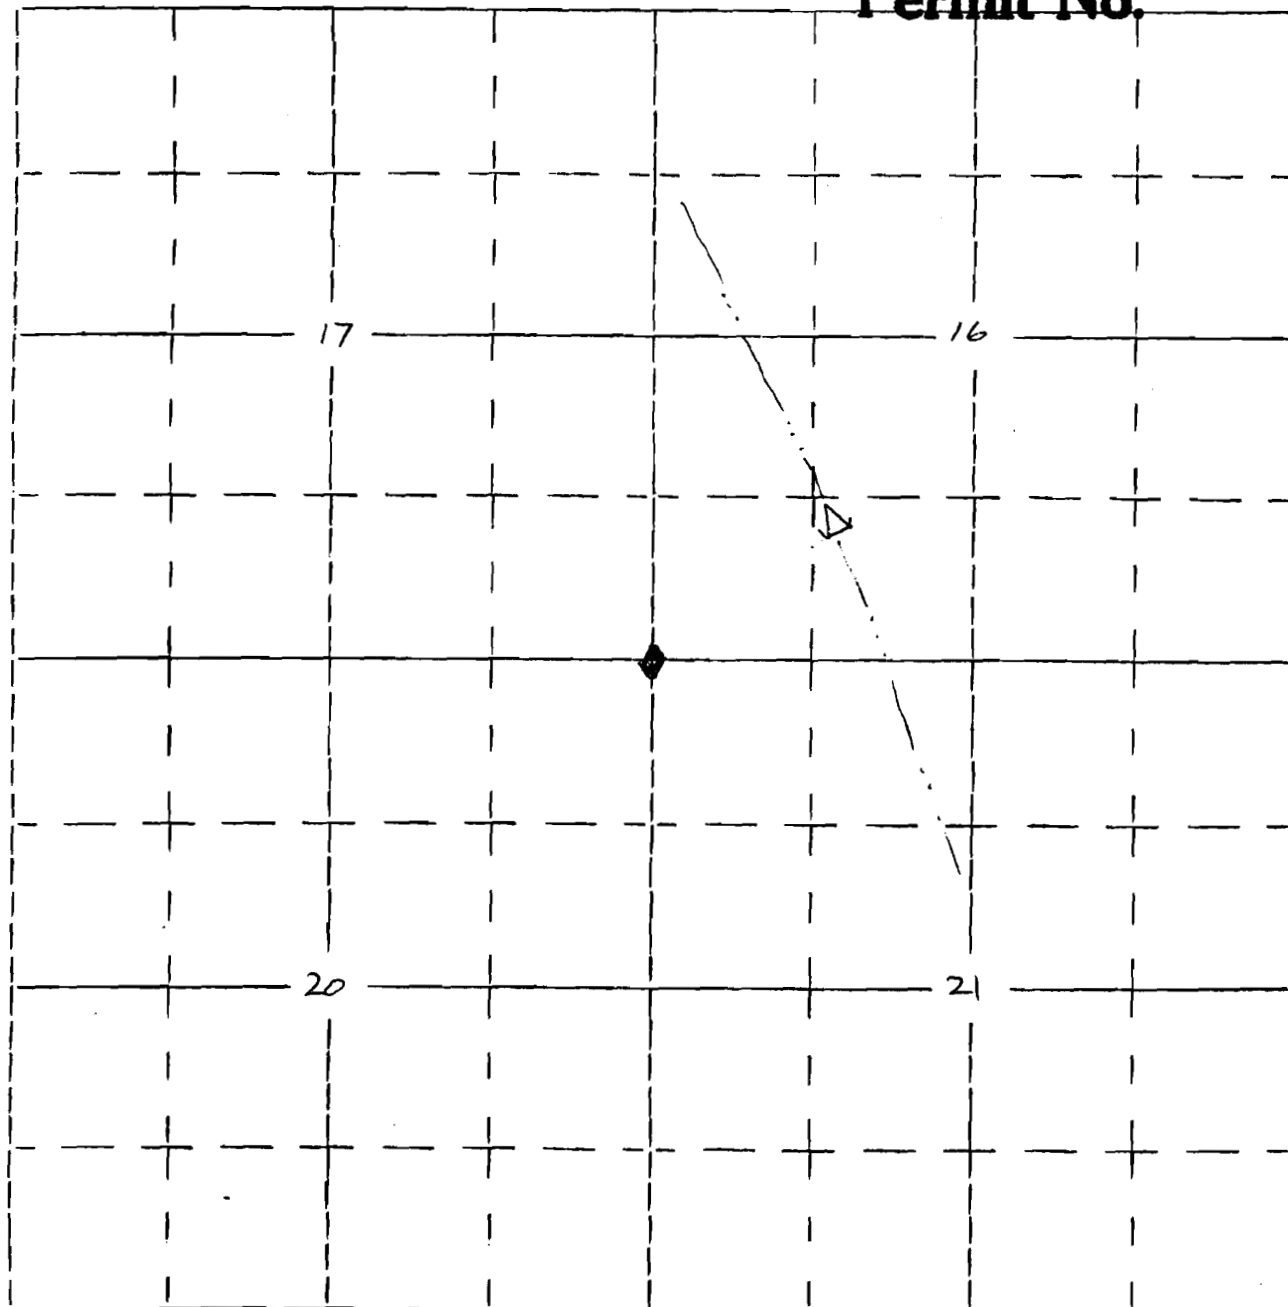

Project is located 1,360' east and 1,155' north of corner common to
Sections 16, 17, 20 & 21.

RECEIVED
SEP 9 1933
WATER RESOURCES DEPT.
SALEM, OREGON