

R10728
(4826) 62462

Form OR-010-7300-2
4/83

UNITED STATES
DEPARTMENT OF THE INTERIOR
BUREAU OF LAND MANAGEMENT

Section

Township 40 S.


Appl. No. R-65996

7, 8, 17 & 18

Range 15 E.

Permit No. R10728

Will. Mer.

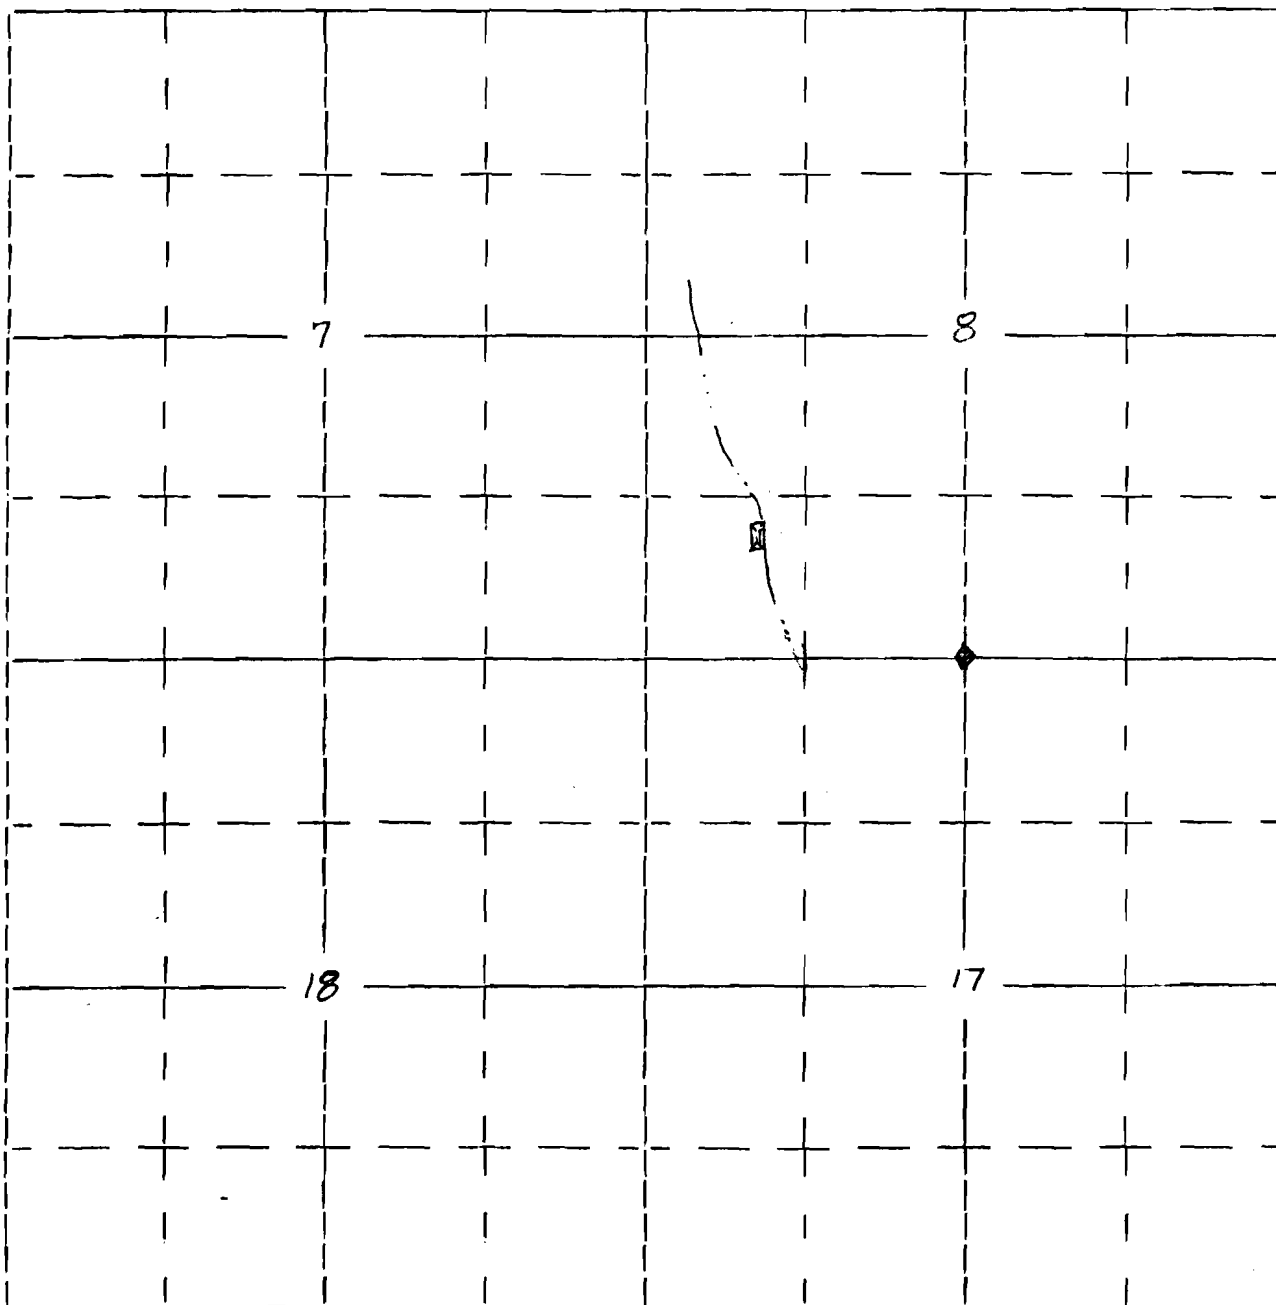

Project is located 1,625' west and 1,155' north of $\frac{1}{4}$ corner common to
Sections 8 & 17.

Application No.
Permit No.

SEP 1933
WATER RESOURCES DEPT.
SALEM, OREGON