

R10729
(4090) 62603

Form OR-010-7300-2
1/83

UNITED STATES
DEPARTMENT OF THE INTERIOR
BUREAU OF LAND MANAGEMENT

Section

Township 40 S.


Appl. No. R-65997

5, 6, 7 & 8

Range 15 E.

Permit No. R10729

Will. Mer.

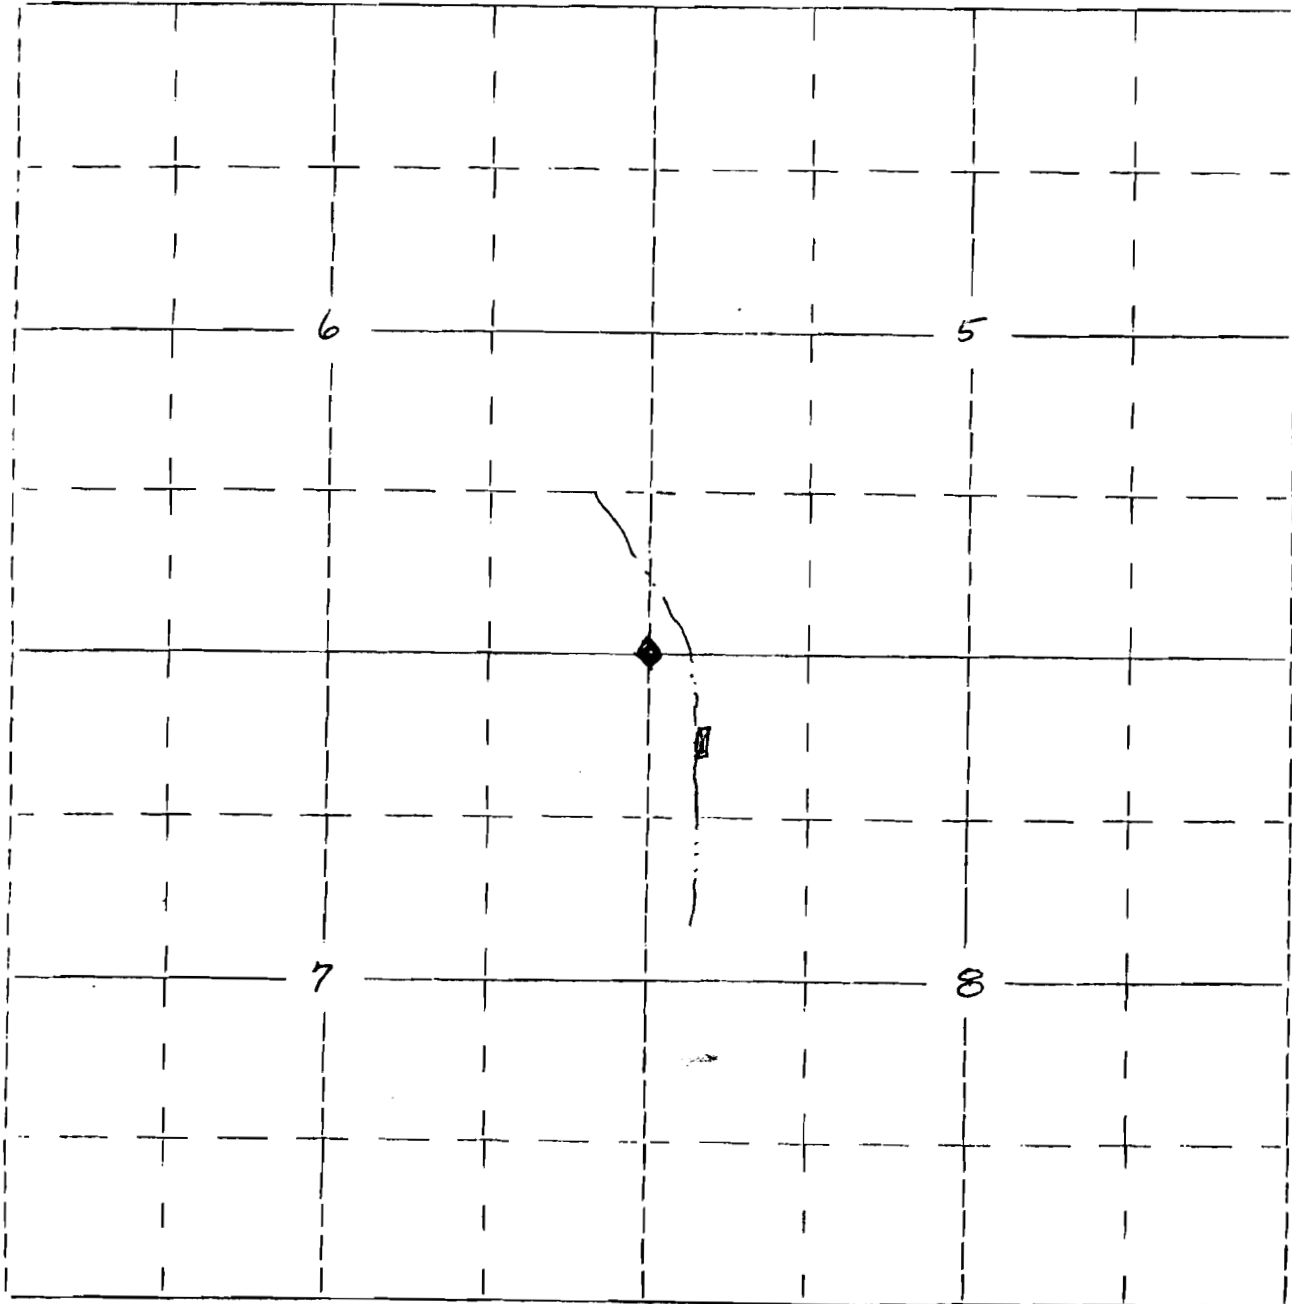

Project is located 660' south and 495' east of corner common to sections
5, 6, 7 & 8.

RECEIVED

Application No.
Permit No.

SEP 9 1983
WATER RESOURCES DEPT.
SALEM, OREGON