

R-10730
62644

(4029)

RECEIVED

SEP 9 1933

WATER RESOURCES DEPT.

SALEM, OREGON

Appl. No. R-65998

Permit No. R10730

Form OR-010-7300-2
1/83

UNITED STATES
DEPARTMENT OF THE INTERIOR
BUREAU OF LAND MANAGEMENT


Section

Township 38 S

21, 22, 27 & 28

Range 11 1/2 E

Will. Mer.

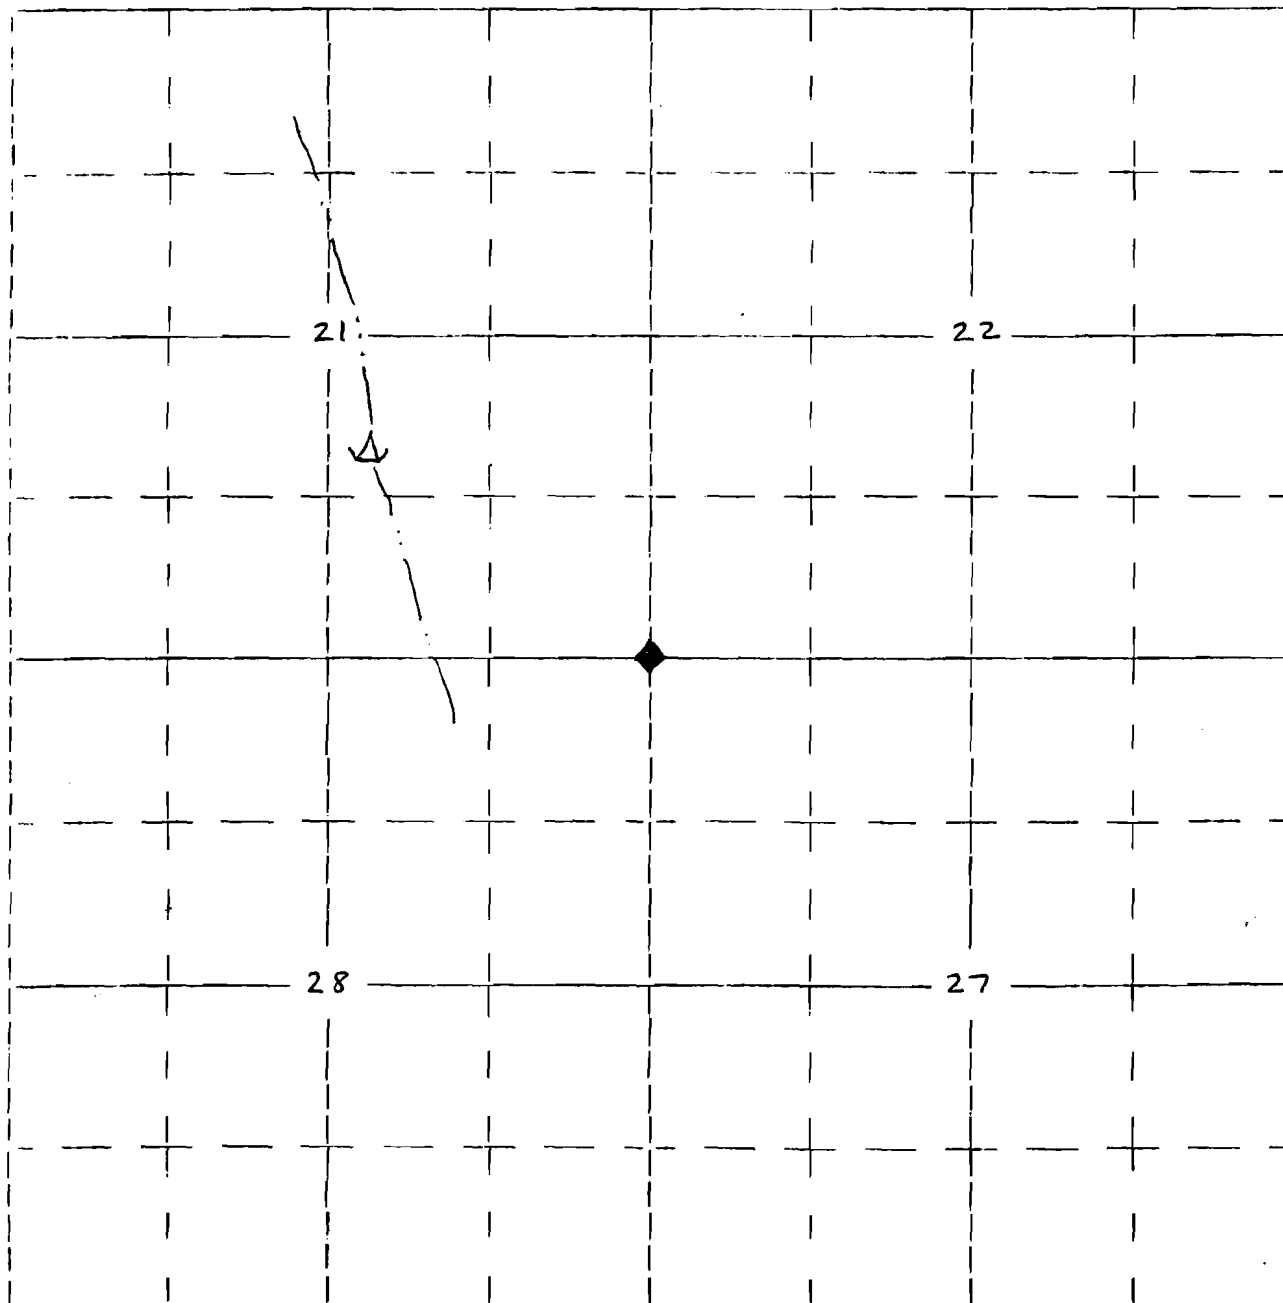

Project is located 1,485' north and 2,310' west of corner common to
Sections 21, 22, 27 & 28.

Application No.

Permit No.