

R10731
(0737) 62665

Form OR-010-7300-2
1/83

UNITED STATES
DEPARTMENT OF THE INTERIOR
BUREAU OF LAND MANAGEMENT

Section


Township 38 S.
39 S.
Range 14 E. & 15 E.

Appl. No. R-65999

Permit No. R10731

25, 36 & 30, 31

Will. Mer.

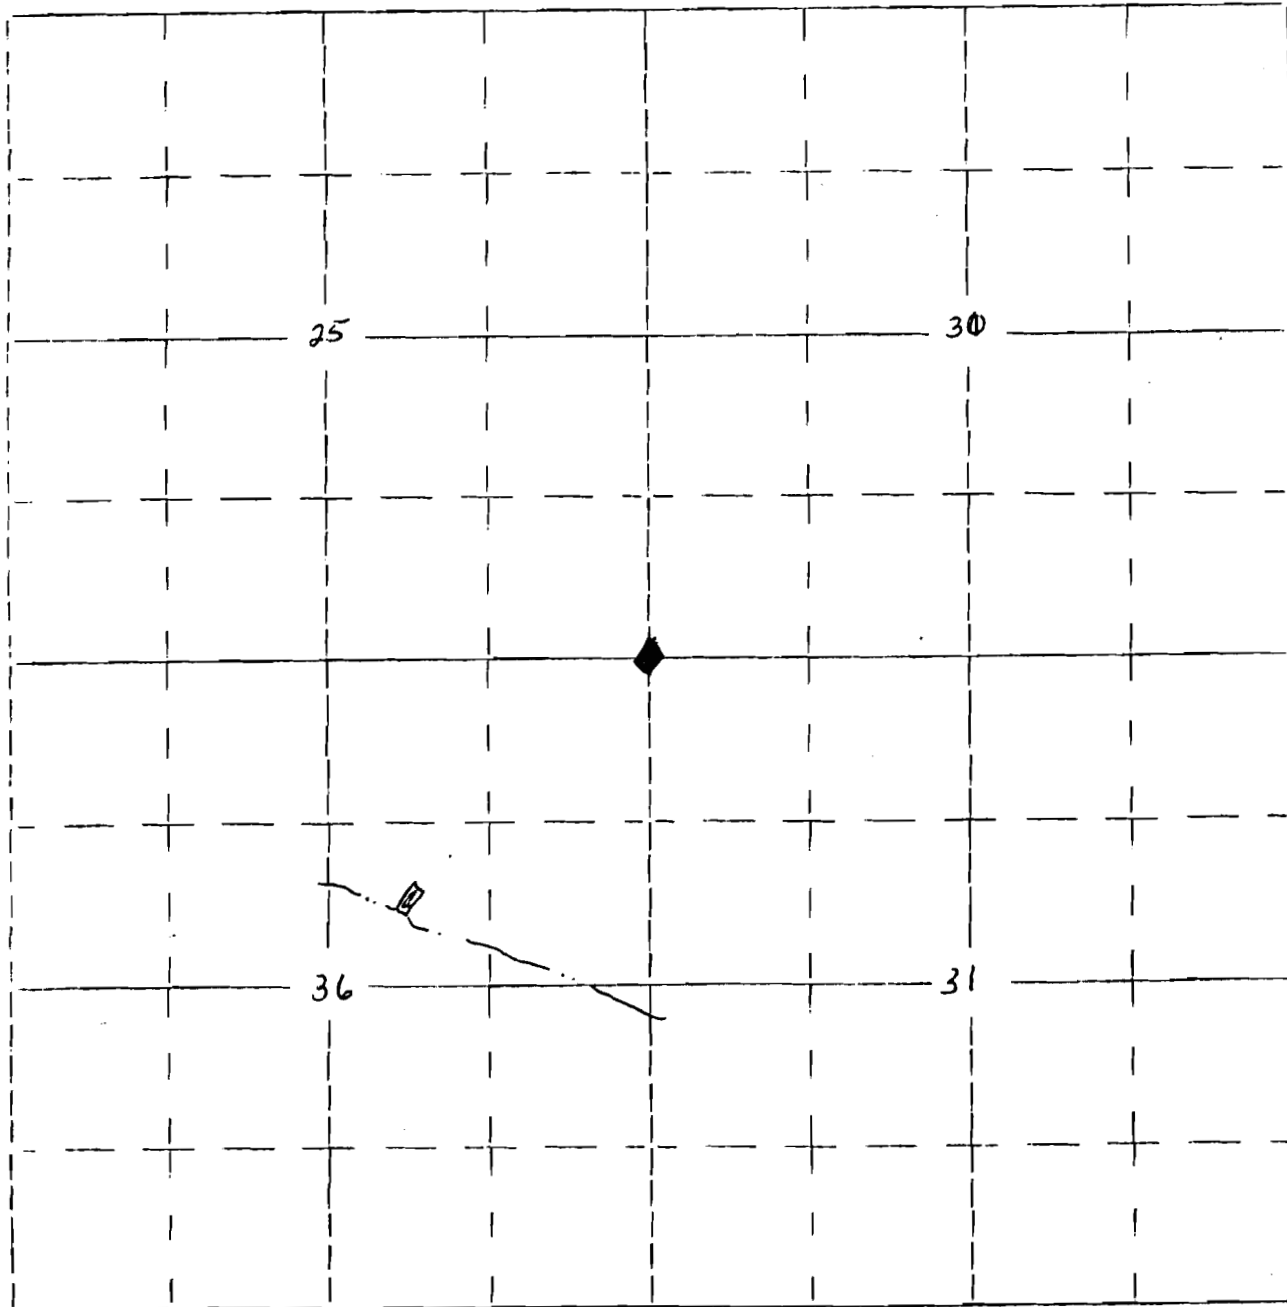

Project is located 2,145' south and 2,145' west of corner common to sections
30, 25, 36 & 31.

RECEIVED

SEP 9 1983
WATER RESOURCES DEPT.
SALEM, OREGON

Application No.
Permit No.