

R-10152
(5389) 62666

Form OR-010-7300-2
1/83

UNITED STATES
DEPARTMENT OF THE INTERIOR
BUREAU OF LAND MANAGEMENT

Section

Township 41 S.


Appl. No. R-66000

8, 9, 16 & 17

Range 14 E.

Permit No. R10732

Will. Mer.

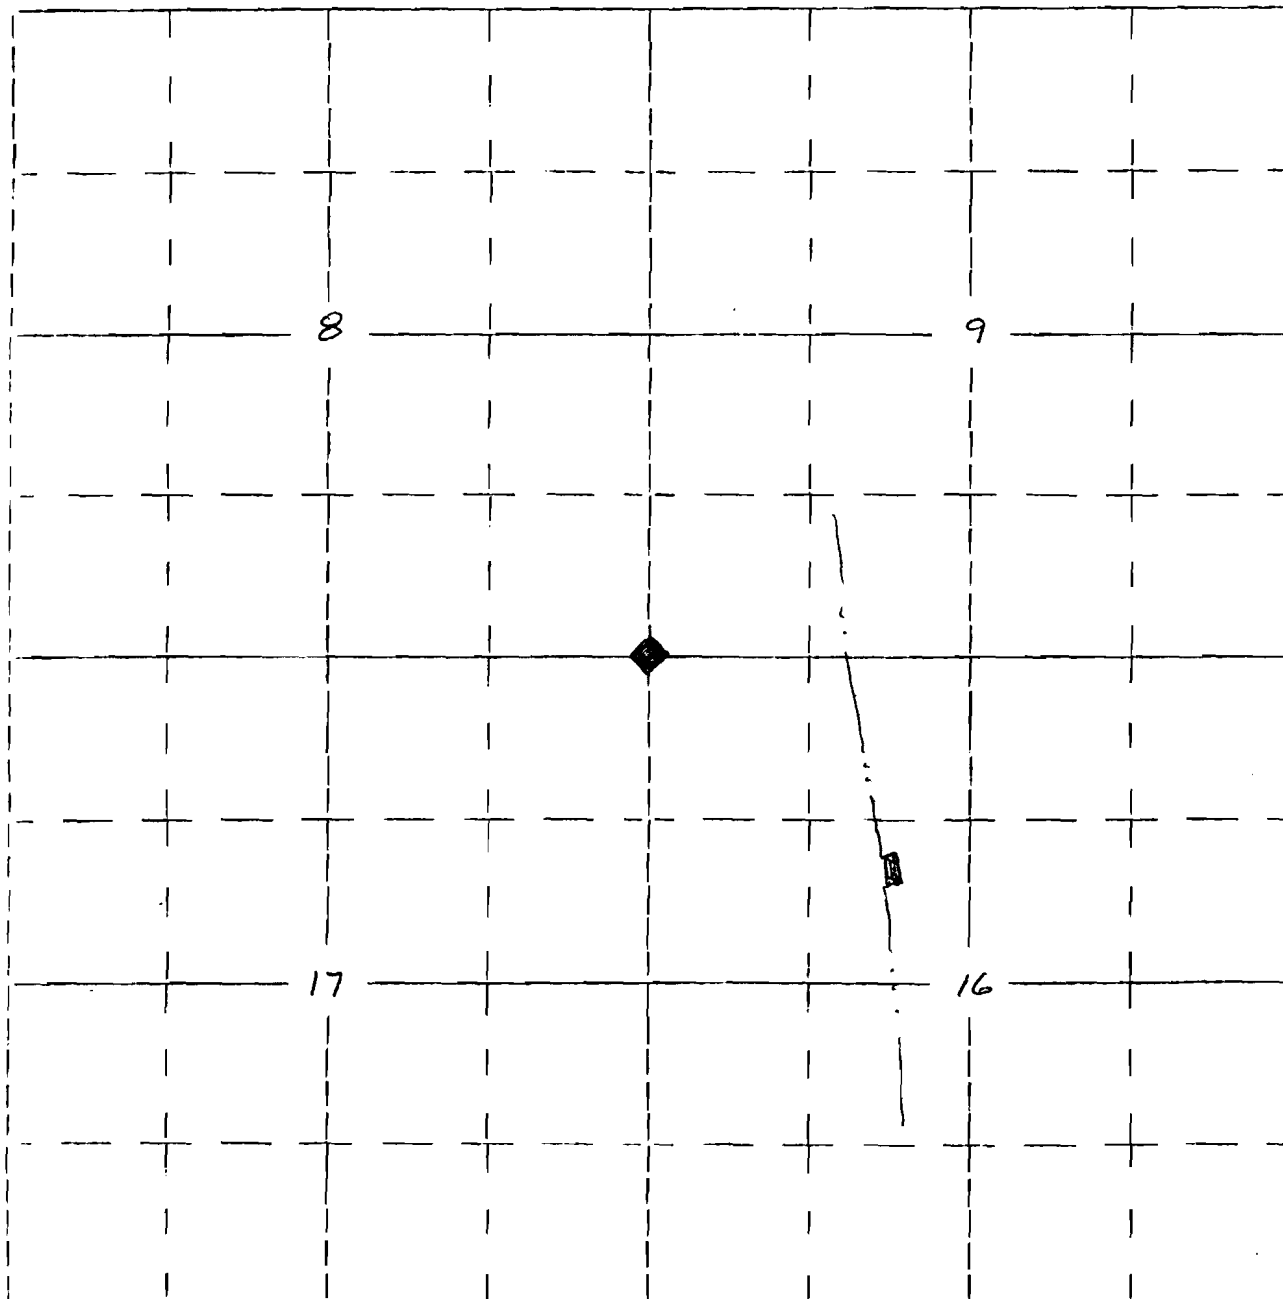

Project is located 2,145' east and 1,815' south of corner common to
Sections 8, 9, 16 & 17.

Application No.
Permit No.

RECEIVED

SEP 9 1933
WATER RESOURCES DEPT.
SALEM, OREGON