

R10733
(5211)62667

Form OR-010-7300-2
1/83

UNITED STATES
DEPARTMENT OF THE INTERIOR
BUREAU OF LAND MANAGEMENT

Section

Township 41 S.


Appl. No. R-66001

6, 1, 12 & 7

Range 14 & 14 1/2 E.

Permit No. R10733

Will. Mer.

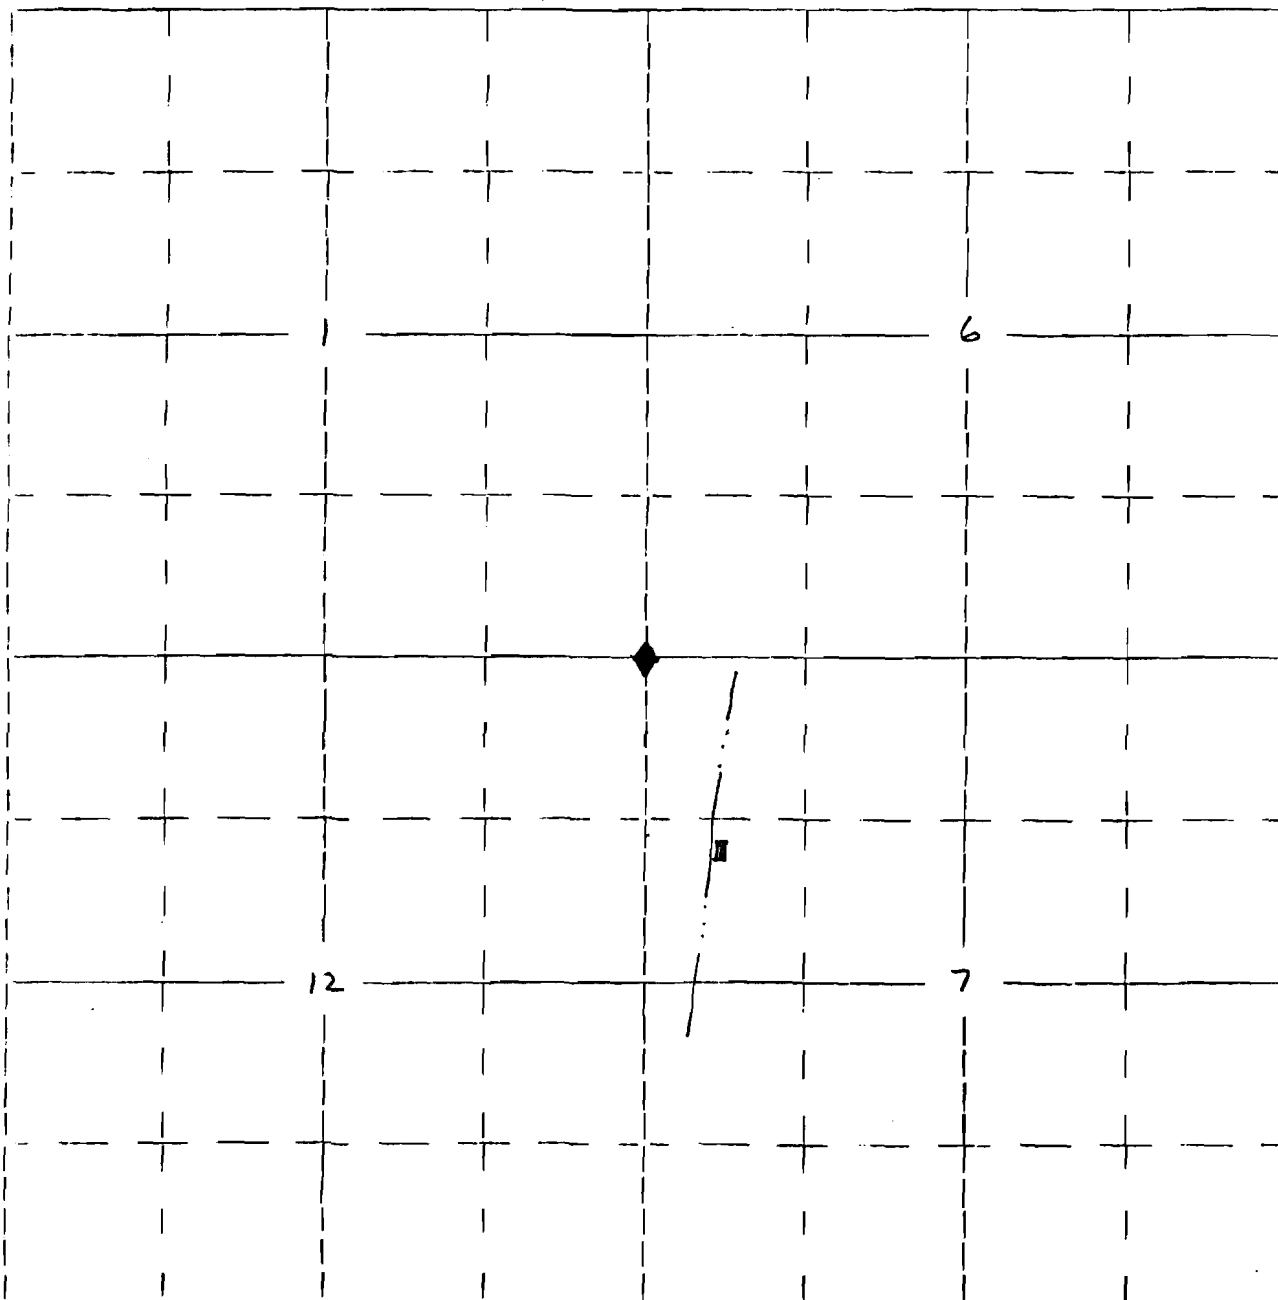

Project is located 1,485' south and 660' east of corner common to
Sections 6, 1, 12 & 7.

Application No.
Permit No.

RECEIVED
SEP 9 1983
WATER RESOURCES DEPT.
SALEM, OREGON