

R10734
(4881) 62668

Form OR-010-7300-2
1/83

UNITED STATES
DEPARTMENT OF THE INTERIOR
BUREAU OF LAND MANAGEMENT

Section

Township 38 S.


Appl. No. R-66002

15, 16, 21 & 22

Range 11 1/2 E.

Permit No. R10734

Will. Mer.

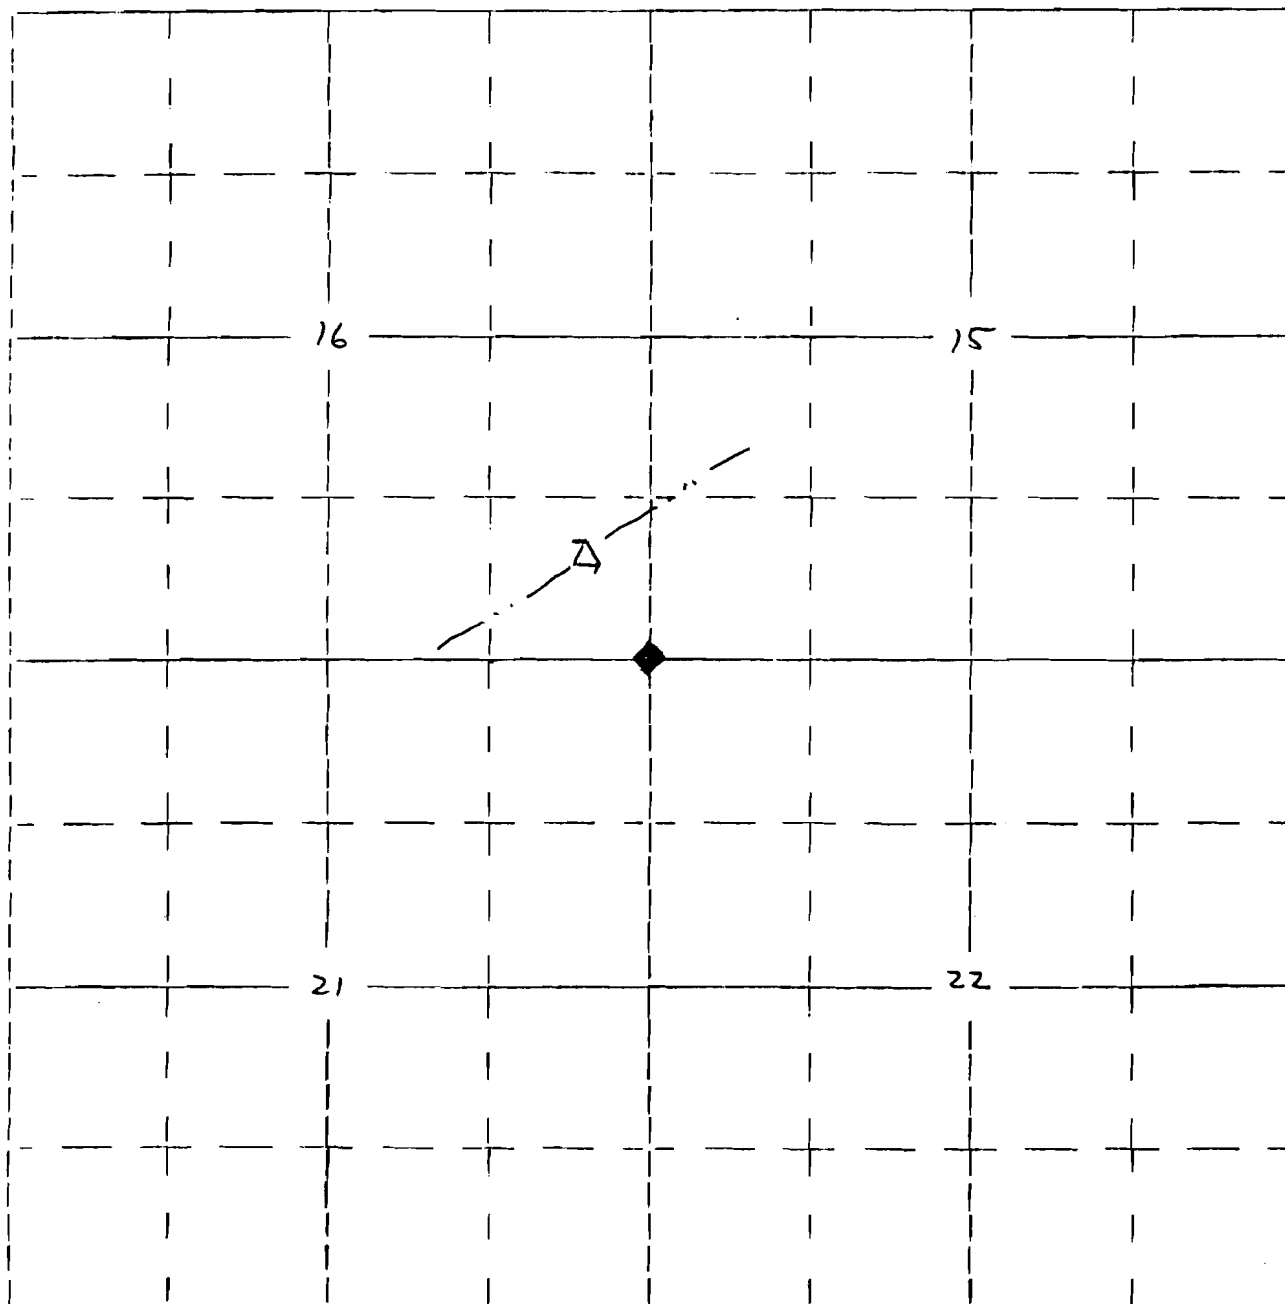

Project located 825' north and 495' west of corner common to sections
15, 16, 21, & 22.

Application No.
Permit No.

RECEIVED
SEP 9 1993
WATER RESOURCES DEPT.
SALEM, OREGON