

R10735
(5206) 62669

Form OR-010-7300-2
1/83

UNITED STATES
DEPARTMENT OF THE INTERIOR
BUREAU OF LAND MANAGEMENT

Section

Township 40 & 41 S.


Appl. No. R-66003

31, 36, 1 & 6

Range 14 & 14½ E.

Permit No. R10735

Will. Mer.

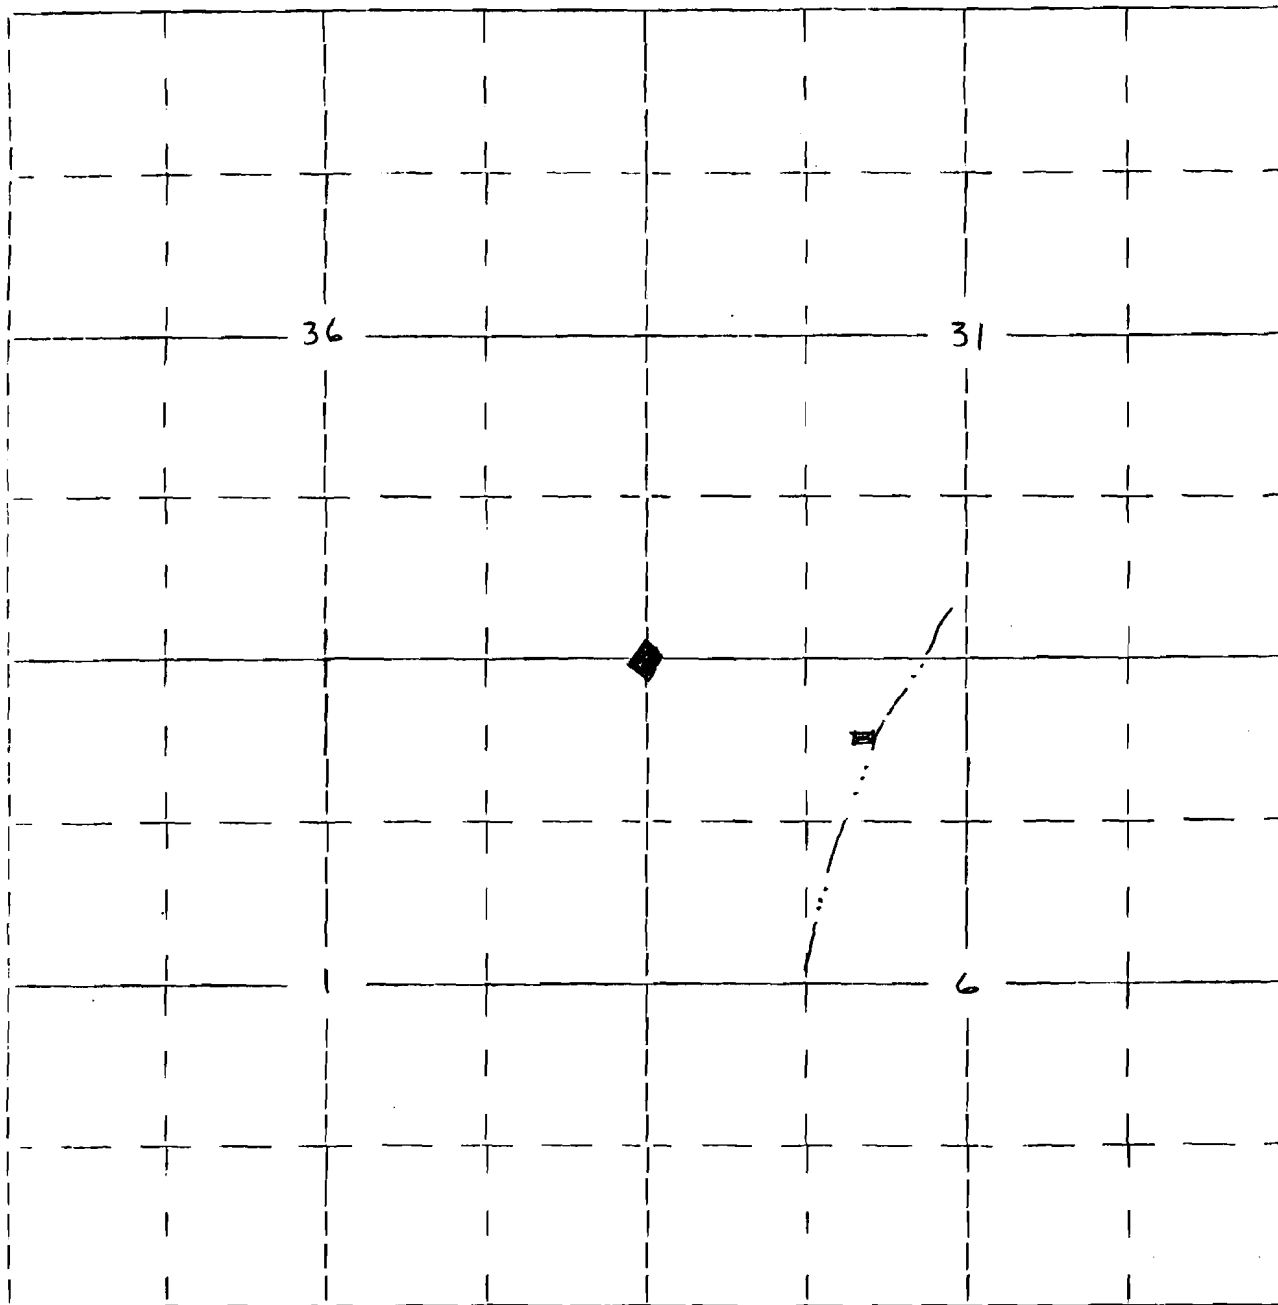

Project is located 1,650' east and 660' south of corner common to sections
31, 36, 1 & 6.

Application No.
Permit No.

RECEIVED
SEP 9 1933
WATER RESOURCES DEPT.
SALEM, OREGON