

(104) **R10736**
62670


Form OR-010-7300-2
4/83

UNITED STATES
DEPARTMENT OF THE INTERIOR
BUREAU OF LAND MANAGEMENT

Section
5, 6, 7 & 8

Township 41 S.
Range 13 E.
Will. Mer.

Appl. No. R-66004
Permit No. R10736

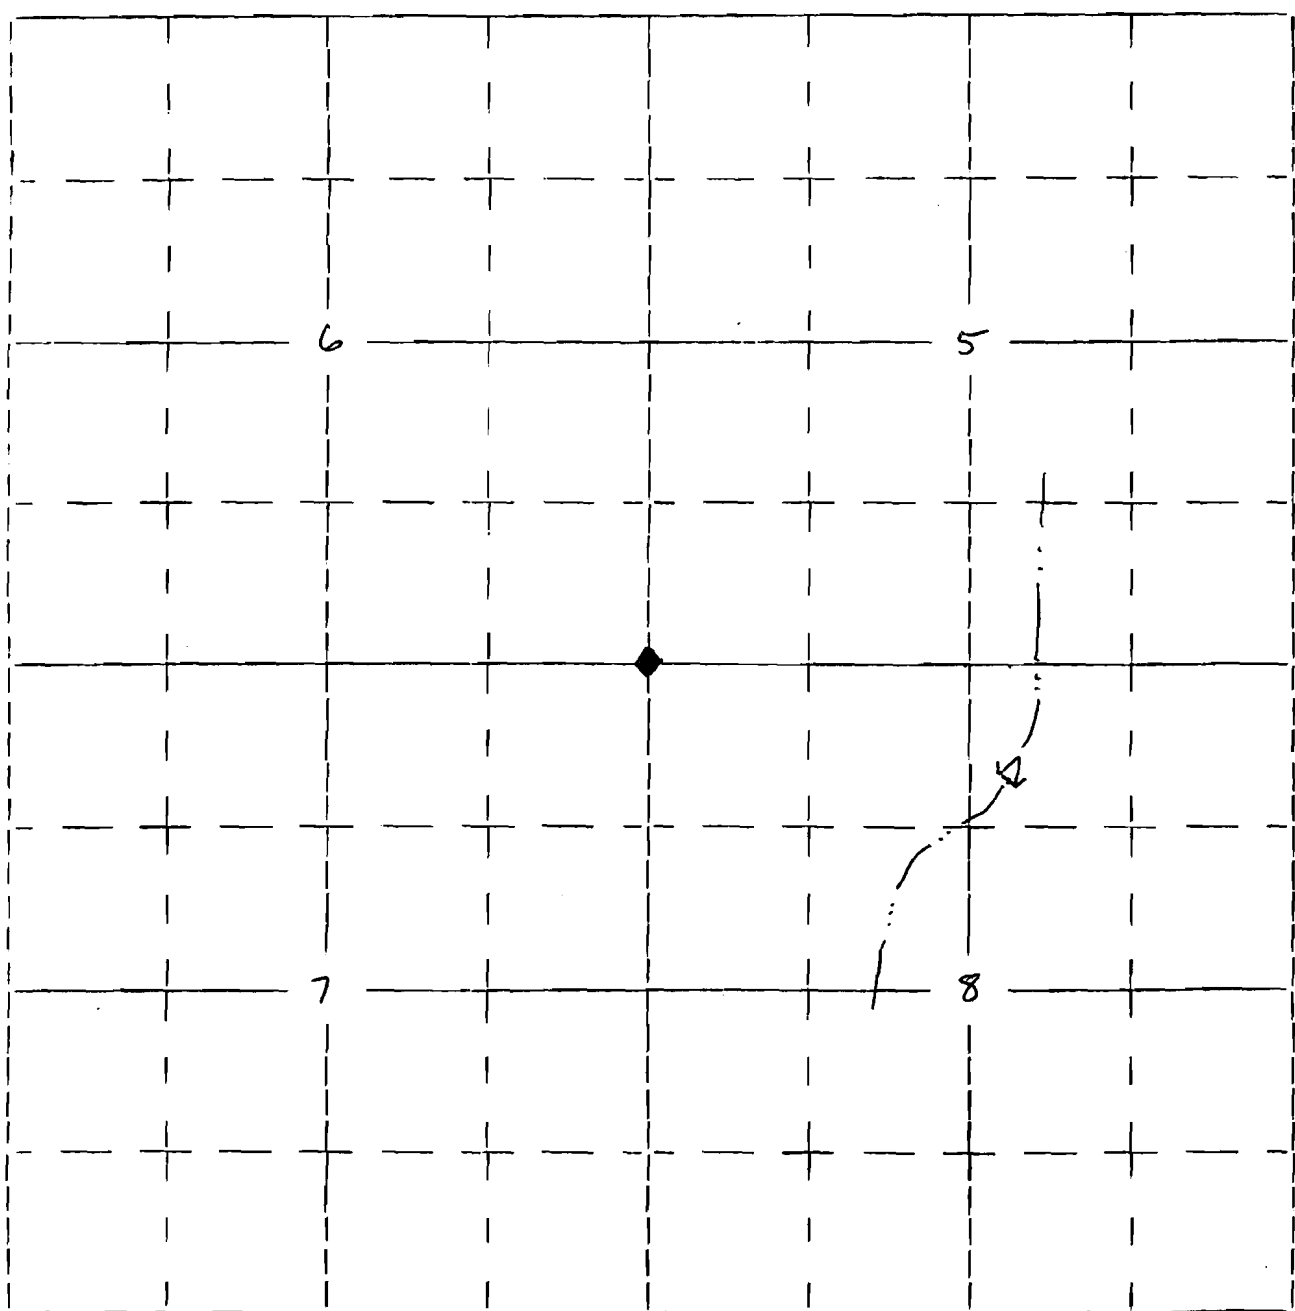

Project is located 2,895' east and 852' south of corner common to sections
5, 6, 7 & 8.

Application No.
Permit No.

SEP 9 1983
WATER RESOURCES DEPT.
SALEM, OREGON