

R10137

(5207) 62671

Form OR-010-7300-2
4/83

UNITED STATES
DEPARTMENT OF THE INTERIOR
BUREAU OF LAND MANAGEMENT

Section

Township 41 S.


Appl. No. R-66005

Permit No. R10737

6, 1, 12 & 7

Range 14 & 14 1/2 E

Will. Mer.

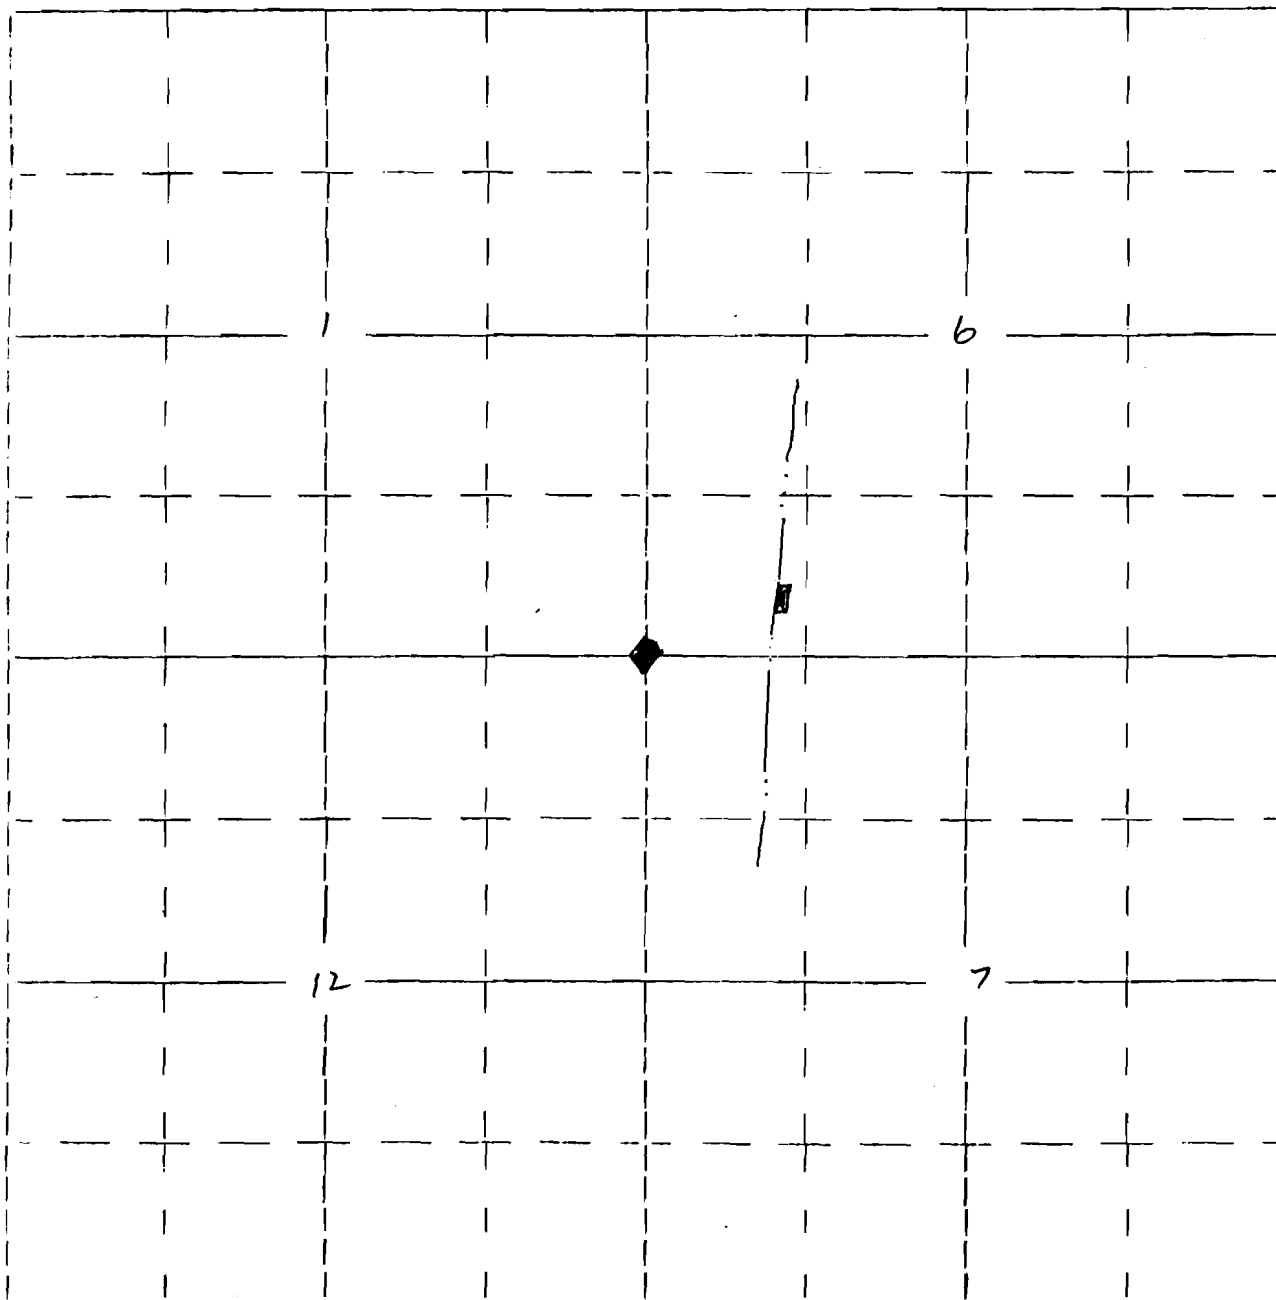

Project is located 1300' east and 495' north of corner common
to sections 6, 1, 12 & 7.

Application No.
Permit No.

RECEIVED
SEP 9 1933
WATER RESOURCES DEPT.
SALEM, OREGON