


T. 5S., R. 2E., W. M.

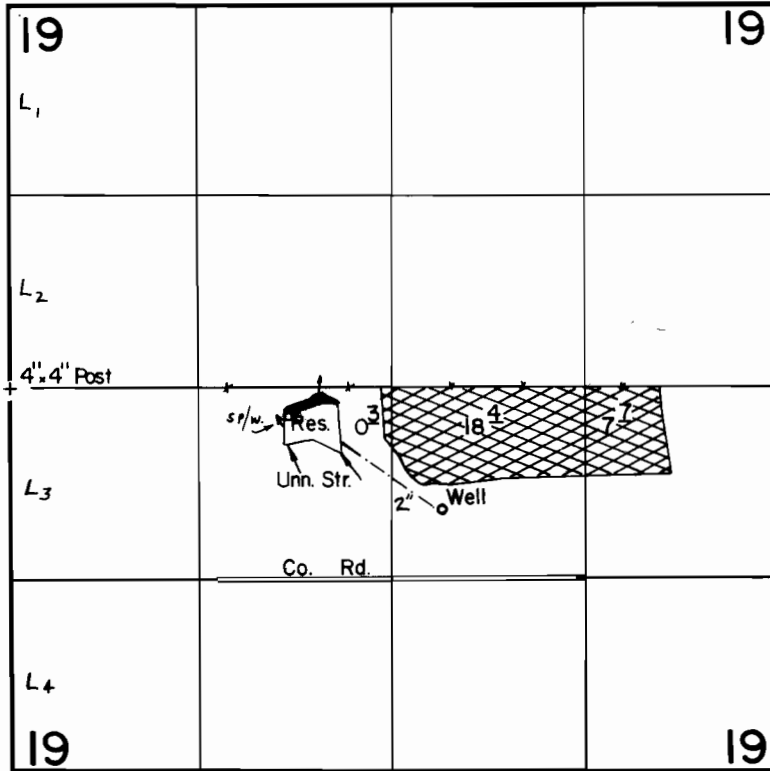

Dam Loc.: 40' S. & 500' W.

Well Loc.: 850' S. & 340' E., both from C. 1/4 Sec. 19.

Scale: 1" = 1320'

FINAL PROOF SURVEY
UNDER

R-56179

R-6664

56180

42017

Application No. G-8259 Permit No. G-7675...



IN NAME OF

LARRY WROLSTAD

Surveyed JUNE 11 1986, by T. Warren
& 12