


T. 5S., R. 2E., W.M.

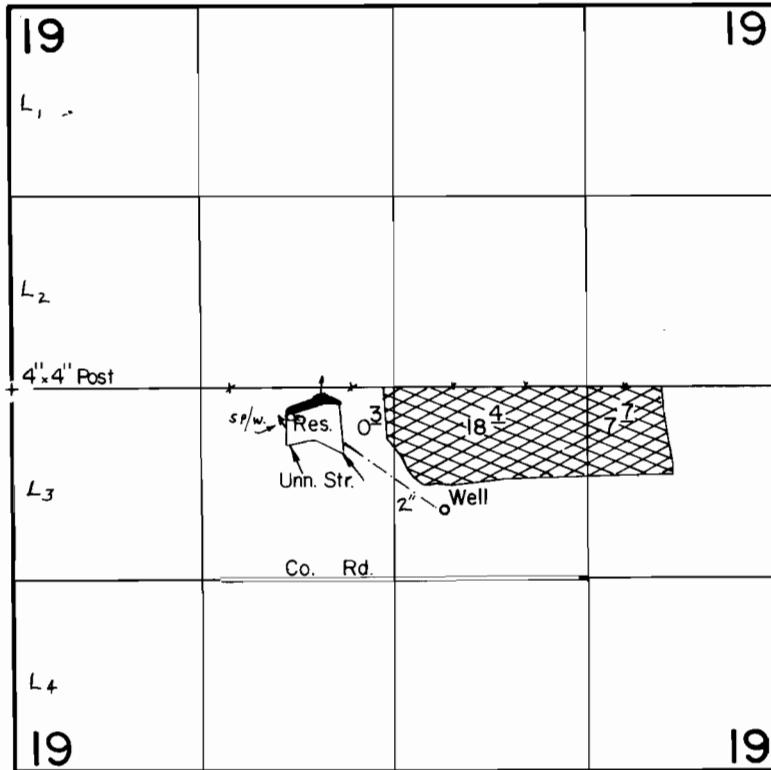

Dam Loc.: 40' S. & 500' W.

Well Loc.: 850' S. & 340' E., both from C. 1/4 Sec. 19.

Scale: 1" = 1320'

FINAL PROOF SURVEY UNDER

R-56179

R-6664

56180

42017

Application No. ~~G-8259~~ Permit No. ~~G-7675~~

IN NAME OF

LARRY WROLSTAD

Surveyed JUNE 11, 1986, by T. Warren
& 12