


T. 23 S., R. 33 & 34 E., WM

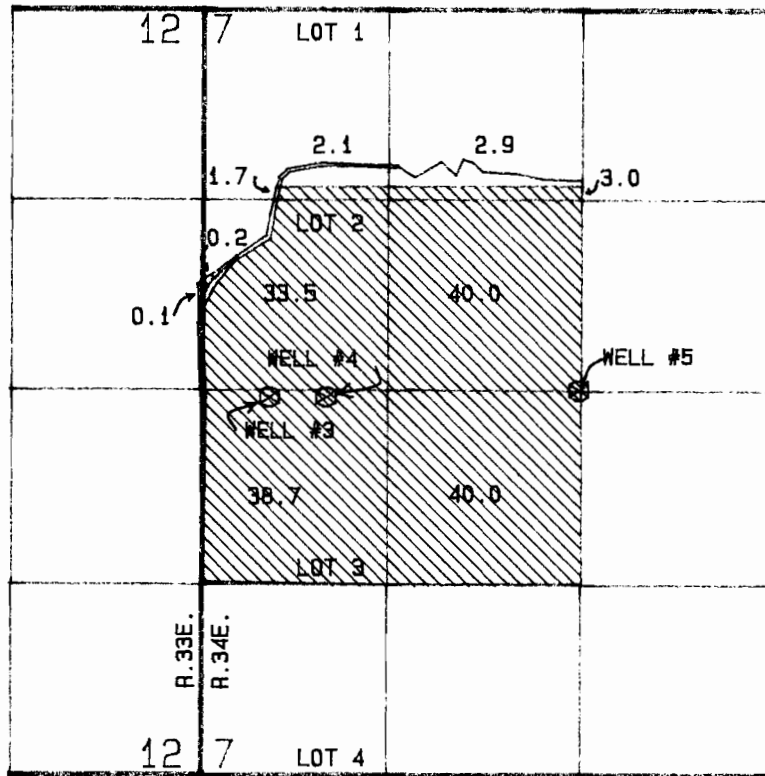

WELLS LOCATED: WELL 3 - 40 FT SOUTH AND 450 FT EAST; WELL 4 - 30 FT SOUTH AND 840 FT EAST; WELL 5 - 30 FT NORTH AND 2570 FT EAST; ALL FROM THE WEST 1/4 CORNER SECTION 7.

SCALE 1 IN = 1320 FT

FINAL PROOF SURVEY

UNDER

APPLICATION NO.: G-8332 PERMIT NO.: G-8152

IN THE NAME OF

WILLIAM C. GEHRKE

SURVEYED MAY 20, 1986 BY: L. M. TOLL

COMPUTER DRAFTED: JCL  
PTS 1986 VALE-A