


T.18S., R. 47E., W.M.

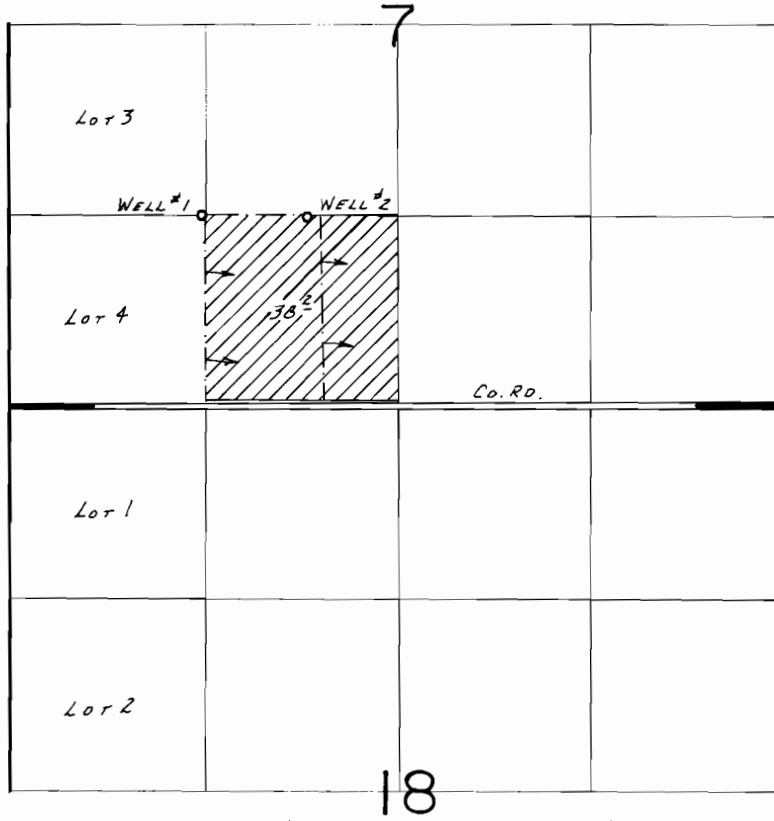

WELLS LOC.: #1- 1320' N. & 1320' E., #2- 1310' N. & 2050' E., BOTH FROM SW COR. SEC. 7.

SCALE: 1"=1320'

### FINAL PROOF SURVEY UNDER

Application No. G:9136.. Permit No. G:8620....  
IN NAME OF

.....JIMMY K. & TARUKO NAKANO.....

Surveyed Mar..6..... 19.86, by L.M. TOLL.....

3/2/87 BJB  
41045-378-280L