


G-8574
62681

T.26S.,R.16E.,W.M.

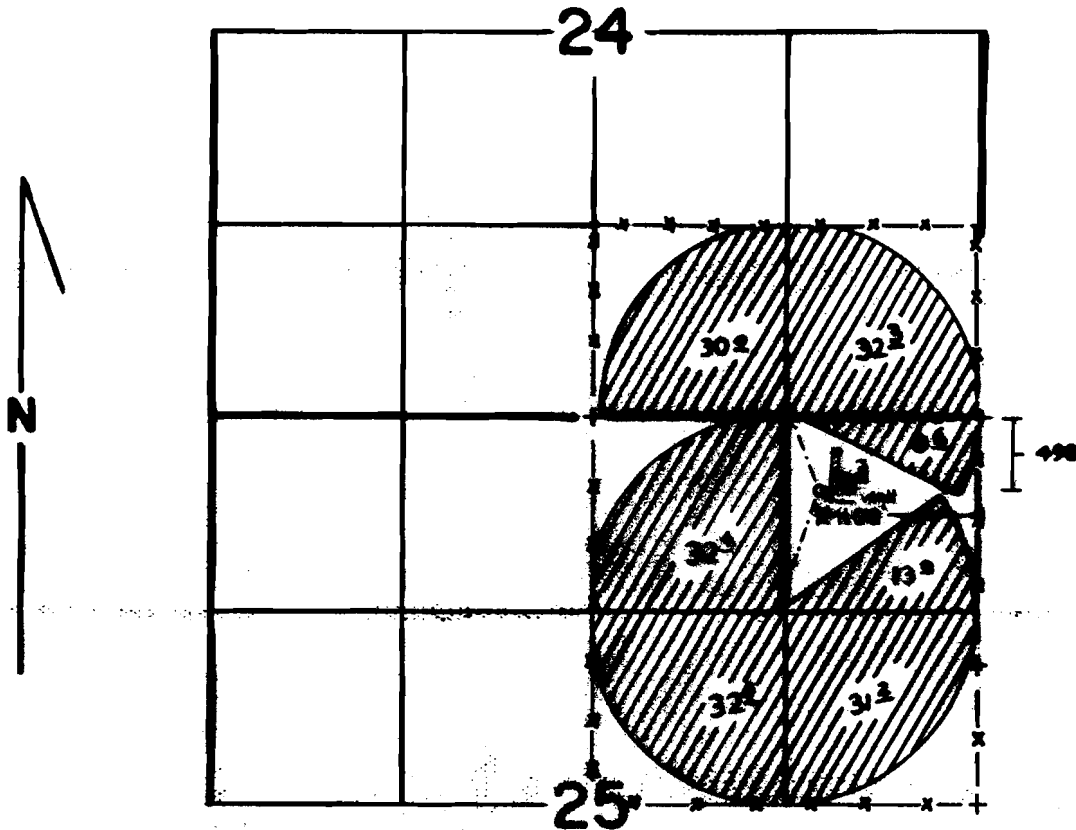

SCALE 1" = 1320'

FINAL PROOF SURVEY
UNDER

Application No. G-9220 Permit No. G-8574.....
IN NAME OF

H. DALE OVERHOLSER

Surveyed JUNE 20, 1985., by LESLIE OLSON....