


T. 24 S., R.33 E., WM.

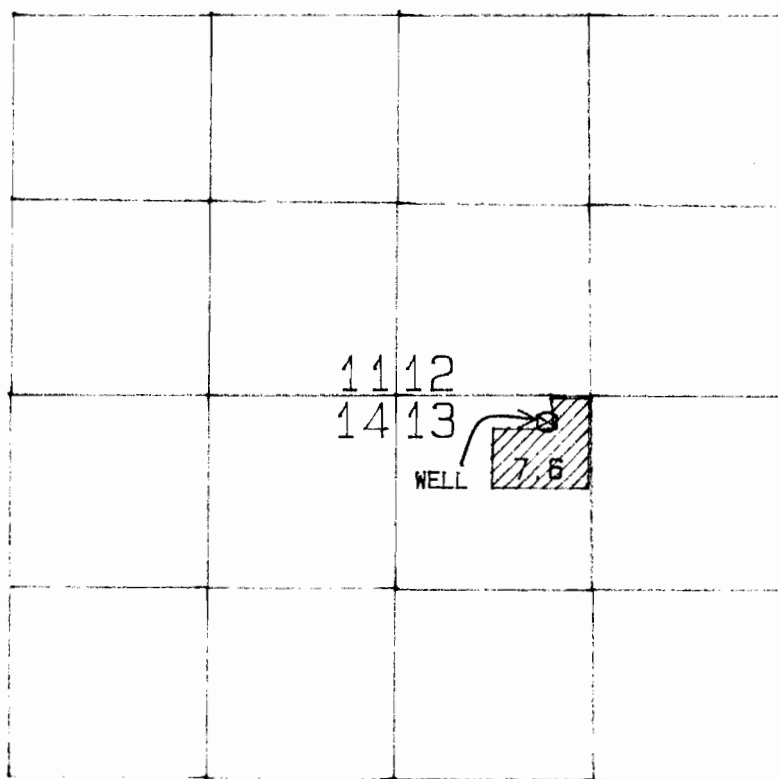

WELL LOCATED: 160 FT SOUTH AND 1030 FT EAST FROM THE
NORTHWEST CORNER OF SECTION 13

SCALE 1 IN = 1320 FT

FINAL PROOF SURVEY
UNDER

APPLICATION NO.: G-9290 , PERMIT NO.: G-8808

ELBERT & LETHA PUGH

SURVEYED MAY 22, 1986 BY: LARRY TOLL

C.A.D. : TMW
PHOTO 41025-179-112R