


T.5S., R. 1E., W.M.

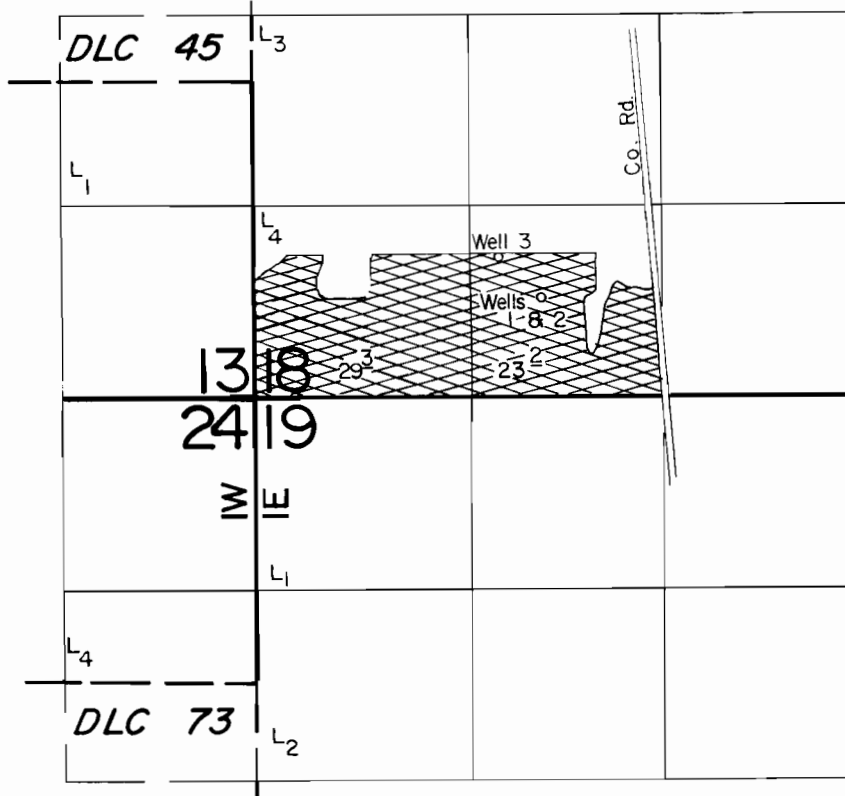

Well 1 Loc.: 650' N. & 1960' E.  
 Well 2 Loc.: 650' N. & 1950' E.  
 Well 3 Loc.: 910' N. & 1670' E., all from SW Cor., Sec. 18.

Scale: 1" = 1320'

**FINAL PROOF SURVEY**  
 UNDER

Application No. ~~G-9335~~ G-9737 Permit No. ~~G-8617~~ G-8852

 Supplemental  
 Primary

IN NAME OF  
**AVERIAN SHADRIN**

Surveyed JUNE 13, 1985, by T. Warren