


T.5S., R. 1E., W.M.

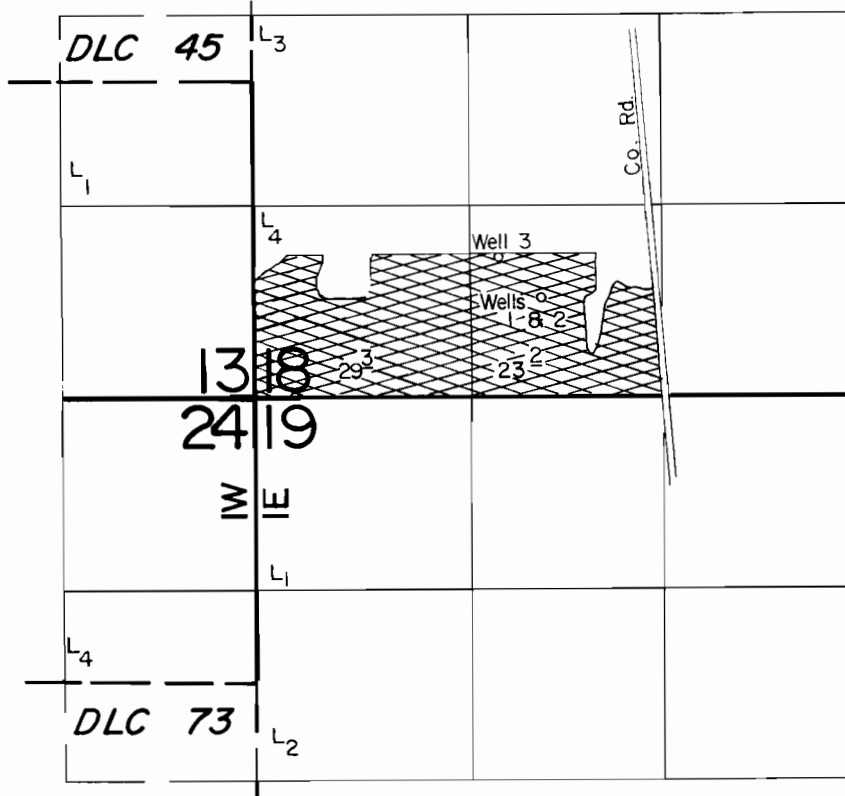

Well 1 Loc.: 650' N. & 1960' E.
 Well 2 Loc.: 650' N. & 1950' E.
 Well 3 Loc.: 910' N. & 1670' E., all from SW Cor., Sec. 18.

Scale: 1" = 1320'

FINAL PROOF SURVEY UNDER

Application No. ~~G-9335~~ G-9737 Permit No. ~~G-8617~~ G-8852

 Supplemental
 Primary

IN NAME OF
AVERIAN SHADRIN

Surveyed JUNE 13, 1985, by T. Warren