


G-8915
62688

T. 28S., R. 14E., W.M.

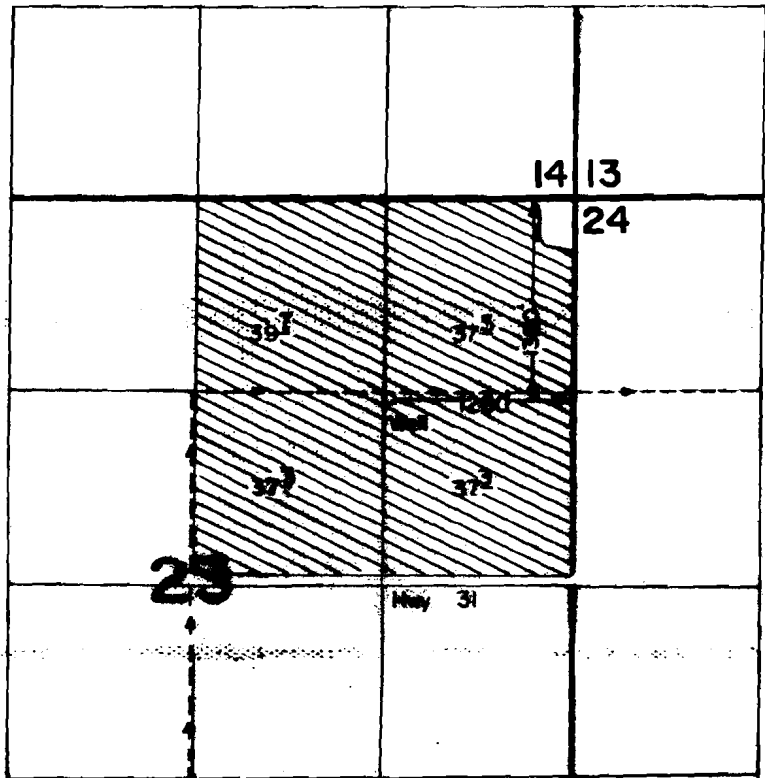

Scale: 1" = 1320'

FINAL PROOF SURVEY UNDER

Application No. G-9556.. Permit No. G-8915.....
IN NAME OF

BELL A. LAND & CATTLE COMPANY

Surveyed Sept. 13, 1985., by T. Warren.....