


29158
62690

T.6N., R.34E., W.M.

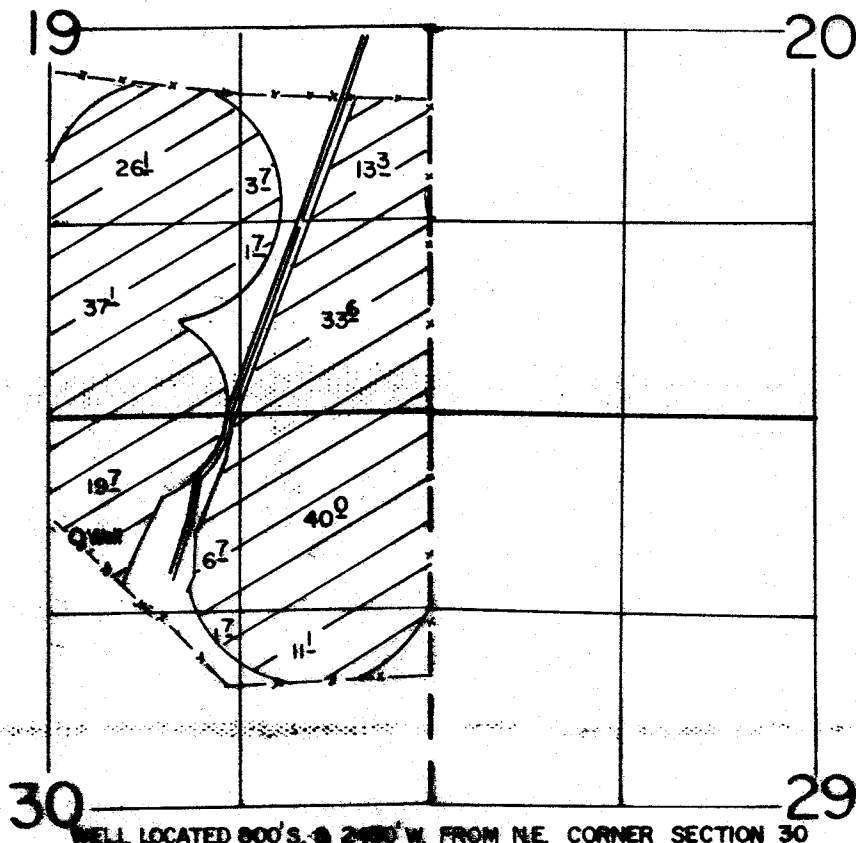

SCALE: 1" = 1320'

FINAL PROOF SURVEY UNDER

Application No. G-9768... Permit No. G-9158.....
IN NAME OF

JAMES KESSLER

Surveyed SEPT. 19..... 1985... by V.L. CHURCH.....