


T.5S., R.1E., W.M.

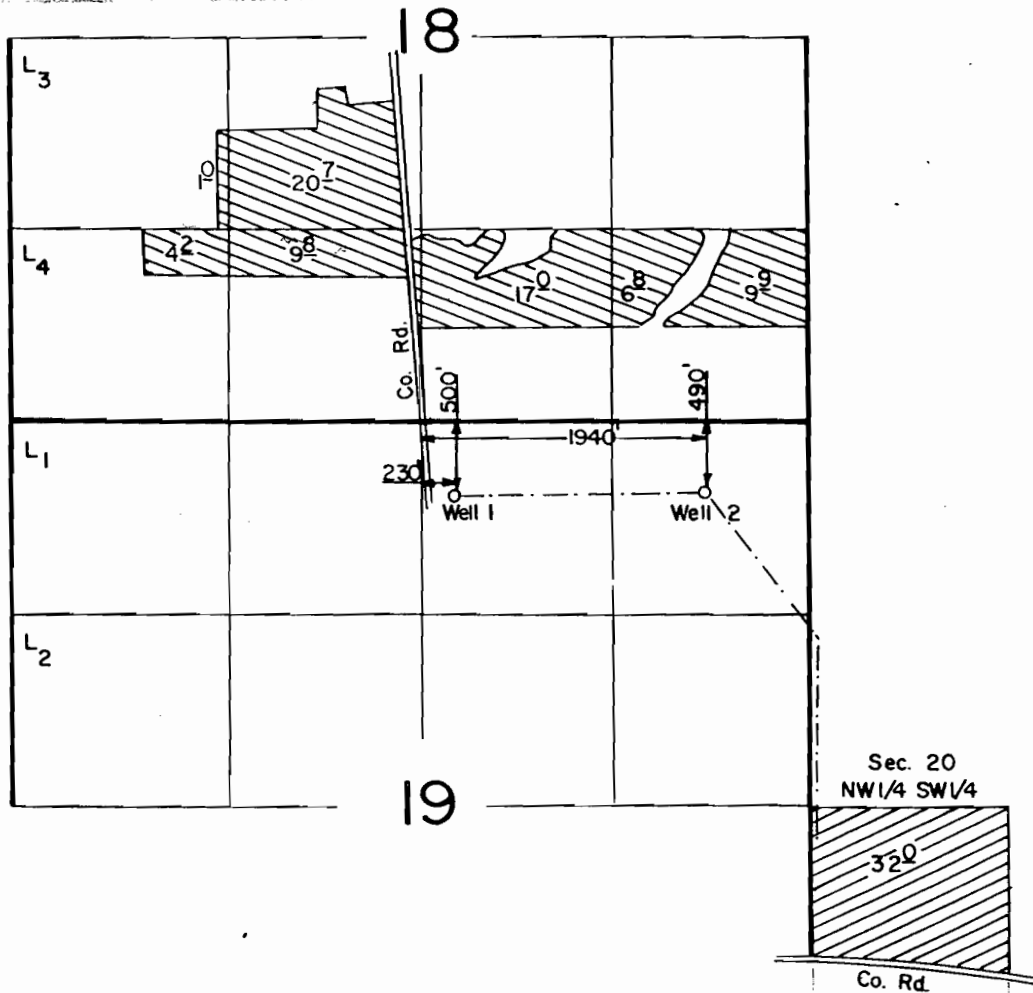

Scale: 1" = 1320'

FINAL PROOF SURVEY
UNDER

G-10142

G-9367


Application No. G-11202... Permit No. G-10294...

IN NAME OF

HESSEL BIERMA

Surveyed JUNE 17, 1985, by T. Warren

8 25

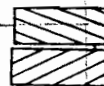

4005-378-146 L
82K-111-133
TMW