
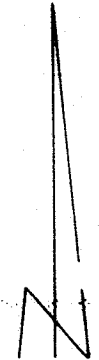


99629

T. 2S., R. 29E., W. M.

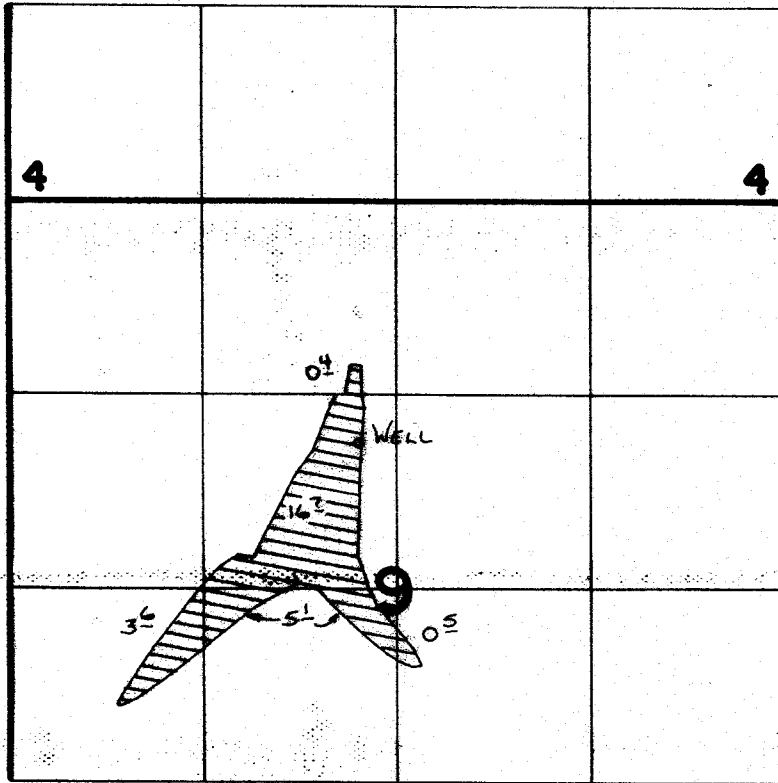

SCALE 1" = 1320'

WELL LOC: 1000' N. & 260' W. FROM CENTER COR SEC 9

FINAL PROOF SURVEY
UNDER

Application No. **G-10169** Permit No. **G-9629**
IN NAME OF

.....**ALLEN HUGHES**.....

Surveyed **12-27** 19**87**, by **V. L. CRUSH**.....