


T. 23S., R. 32 1/2E, W.M.

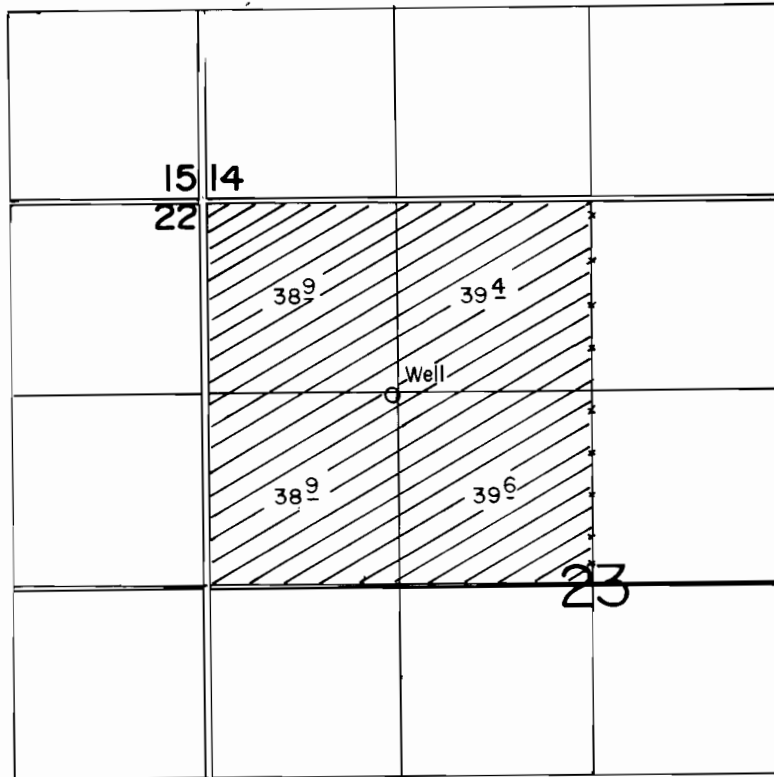

Well Located 1350' S. & 1250' E. From NW Corner Section 23

SCALE: 1" = 1320'

**FINAL PROOF SURVEY**  
UNDER

Application No. G-10209.. Permit No. G-9274.....

IN NAME OF

**DENNIS JAY & LOLA M. BENTON**.....

Surveyed JULY 15, 1986, by DON CLARK.....