


T.13S., R.16E., W.M.

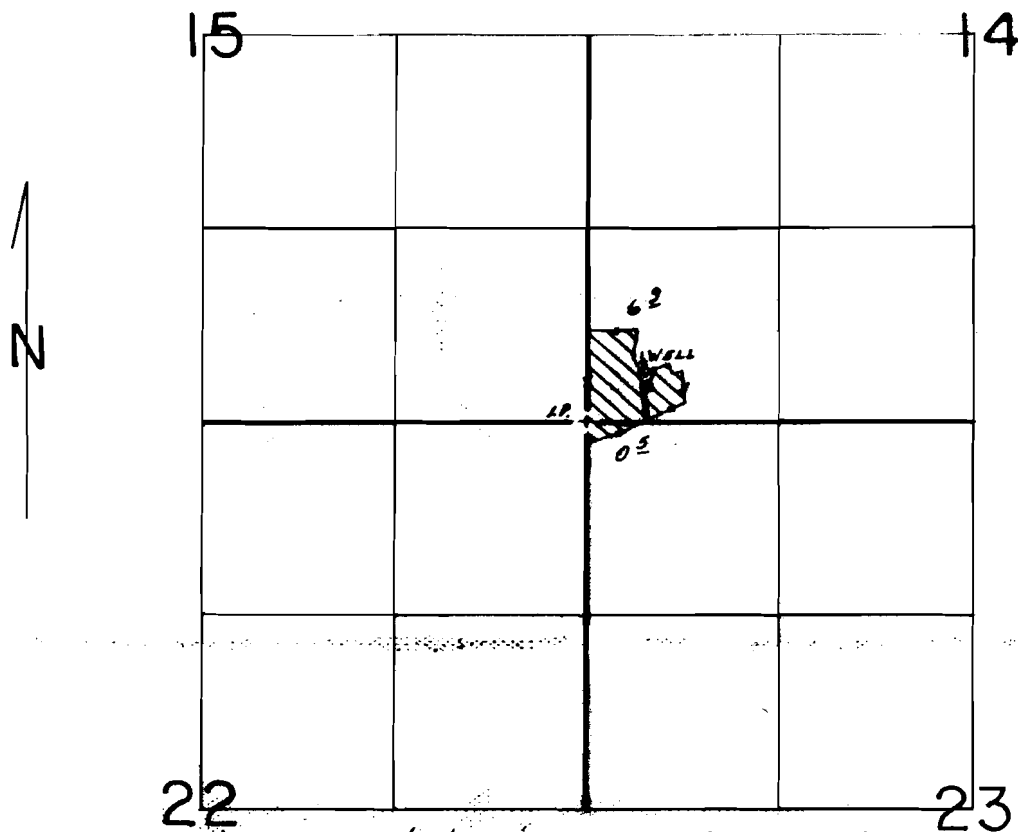

WELL LOC.: 310' N. & 390' E. FROM SW COR. SEC. 14.

SCALE: 1" = 1320'

FINAL PROOF SURVEY
UNDER

Application No. G-10426 Permit No. G-9604.....
IN NAME OF

C- 62696

.....ALBERT E. JOHNSON.....

Surveyed Mar. 20 19.87, by M.J. MATTICK.....

also bid
PTS 11-1987A

G-9604